


**CERTIFIED RECORD OF LAND CORNER MONUMENTATION**

**HISTORY OF ORIGINAL CORNER ESTABLISHMENT:**

THIS CORNER WAS ORIGINALLY ESTABLISHED BY W.R. GRADON UNDER CONTRACT NO. 409 DATED MAR. 28, 1882.

SURVEYOR GENERAL LAND OFFICE RECORDS STATE:  
 "SET A POST 4 FT LONG, 4 INCHES SQUARE, WITH A MARKED STONE, 12" IN GROUND FOR THE CORNER TO SECTIONS 29,30,31 & 32, MARKED T12S S29 ON NE, R37E S32 ON SE, S31 ON SW AND S30 ON NW FACES WITH 1 NOTCH ON S. AND 5 NOTCHES ON E. EDGES.  
 DUG PITS 18"X18"X12" IN EACH SEC. 5.5 FT. DIST. AND RAISED A MOUND OF EARTH 2 FT., 4.5 FT AT BASE AROUND POST AND MONUMENTATIONS."

**DIAGRAM**

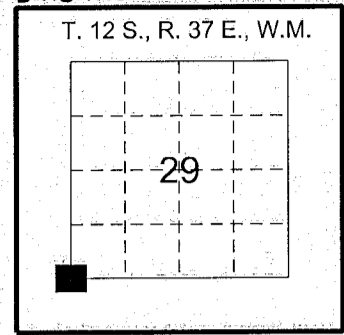

**DESCRIPTION OF CORNER EVIDENCE FOUND:**

HELD CENTER OF ROUSE LANE IN NORTH-SOUTH DIRECTION AS BEST EVIDENCE OF THE SOUTH LINE OF SECTION 29.

**DESCRIPTION OF MONUMENT AND ACCESSORIES I ESTABLISHED TO PERPETUATE THE ORIGINAL LOCATION OF THIS CORNER:**


RE-ESTABLISHED THE CORNER BY HOLDING THE CENTER OF ROUSE LANE IN THE NORTH-SOUTH DIRECTION AND USED PROPORTIONING BETWEEN THE 3-1/4" ALUMINUM CAP FOUND AT THE NORTH QUARTER CORNER OF SECTION 31 AND THE REMONUMENTED INTERSECTION OF ROUSE LANE WITH THE NORTH-SOUTH FENCE LINE AT THE NORTH QUARTER CORNER OF SECTION 32 IN THE EAST-WEST DIRECTION, AS SHOWN ON THE RECORD OF SURVEY FOR THE UNITY RESERVOIR QUARRY BOUNDARY RESOLUTION FILED CONCURRENTLY WITH THIS CORNER MONUMENTATION RECORD.

SET 3-1/4" ALUMINUM CAP ON A 5/8"X30" IRON ROD, 3" BELOW THE GRAVEL SURFACE, IN ROUSE LANE.

THE CAP IS MARKED AS SHOWN BELOW.

THE REFERENCES SET FOR SAID CORNER ARE AS FOLLOWS:

- 1) A 1/2" X 30" SQUARE IRON ROD WITH A 1-1/2" ALUMINUM CAP, DOWN 1", STAMPED "ODOT" BEARS N47°20'01"E, 49.35 FEET.
- 2) A 1/2" X 30" SQUARE IRON ROD WITH A 1-1/2" ALUMINUM CAP, DOWN 1", STAMPED "ODOT" BEARS S43°35'29"E, 41.98 FEET.
- 3) A 1/2" X 30" SQUARE IRON ROD WITH A 1-1/2" ALUMINUM CAP, DOWN 1", STAMPED "ODOT" BEARS S28°37'01"W, 35.46 FEET.
- 4) A 1/2" X 30" SQUARE IRON ROD WITH A 1-1/2" ALUMINUM CAP, FLUSH, STAMPED "ODOT" BEARS N38°48'58"W, 40.64 FEET.

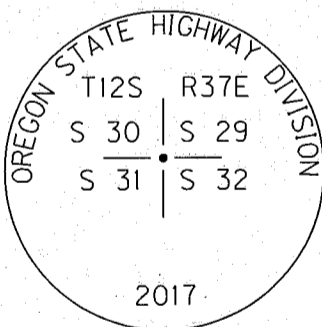

WITNESSES:  
 MARK STEWART, CHASE KING

I HEREBY CERTIFY THAT THE ABOVE CORNER POSITION WAS RE-ESTABLISHED AS HEREON DESCRIBED ON MARCH 27, 2017.

REGISTERED  
 PROFESSIONAL  
 LAND SURVEYOR

*Bret N. Elithorp*

OREGON  
 JAN 14, 2003  
 BRET N. ELITHORP  
 61348

RENEWS: 12/31/2017

OREGON DEPARTMENT OF TRANSPORTATION



FILED May 17, 2017

BAKER COUNTY SURVEYOR

SURVEY NO. 12-39-106

Section	UNITY RESEVOIR QUARRY		
Highway	DOOLEY MOUNTAIN HIGHWAY		
County	BAKER	Scale	NTS
Purpose	QUARRY BOUNDARY	Date	APRIL 10, 2017