


**CERTIFIED RECORD OF LAND CORNER MONUMENTATION**

**HISTORY OF ORIGINAL CORNER ESTABLISHMENT:**

THIS CORNER WAS ORIGINALLY ESTABLISHED BY W.R. GRADON UNDER CONTRACT NO. 409 DATED MAR. 28, 1882.

SURVEYOR GENERAL LAND OFFICE RECORDS STATE:  
 "SET A POST 3-1/2 FT LONG, 3 INCHES SQUARE, WITH A MARKED STONE, 12" IN GROUND FOR THE 1/4 SEC COR. MARKED 1/4 S. ON N. FACE DUG PITS 18"X18"X12" IN E. & W. OF COR. 5.5 FT. DIST. AND RAISED A MOUND OF EARTH 1-1/2 FT. HIGH, 3.5 FT AT BASE AROUND POST"

**DIAGRAM**

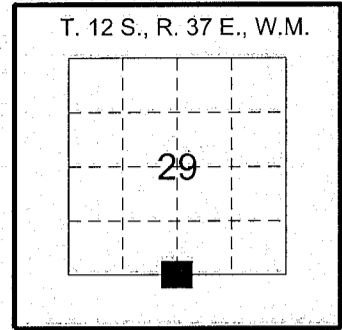

V-7

**DESCRIPTION OF CORNER EVIDENCE FOUND:**

HELD CENTER OF ROUSE LANE IN NORTH-SOUTH DIRECTION AS BEST EVIDENCE OF THE SOUTH LINE OF SECTION 29. HELD NORTH-SOUTH FENCELINE ON THE EAST LINE OF NORTHWEST QUARTER OF SECTION 32 AS BEST EVIDENCE OF SAID QUARTER SECTION LINE

**DESCRIPTION OF MONUMENT AND ACCESSORIES ESTABLISHED TO PERPETUATE THE ORIGINAL LOCATION OF THIS CORNER:**


RE-ESTABLISHED THE CORNER BY HOLDING CENTER OF ROUSE LANE IN NORTH-SOUTH DIRECTION AND HELD A NORTH-SOUTH FENCE LINE EXTENDED NORTHERLY TO INTERSECTION WITH CENTER OF ROUSE LANE IN EAST-WEST DIRECTION, AS SHOWN ON THE RECORD OF SURVEY FOR THE UNITY RESERVOIR QUARRY BOUNDARY RESOLUTION FILED CONCURRENTLY WITH THIS CORNER MONUMENTATION RECORD.

SET 3-1/4" ALUMINUM CAP ON A 5/8"X30" IRON ROD, 6" BELOW THE GRAVEL SURFACE, IN CENTER OF ROUSE LANE.

THE CAP IS MARKED AS SHOWN BELOW.

THE REFERENCES SET FOR SAID CORNER ARE AS FOLLOWS:

- 1) A 5/8" X 30" SMOOTH IRON ROD WITH A 1-1/2" ALUMINUM CAP, DOWN 2", STAMPED "ODOT" BEARS N56°56'38"E, 24.91 FEET.
- 2) A 5/8" X 30" SMOOTH IRON ROD WITH A 1-1/2" ALUMINUM CAP, DOWN 2", STAMPED "ODOT" BEARS S61°52'26"E, 22.23 FEET.
- 3) A 5/8" X 30" SMOOTH IRON ROD WITH A 1-1/2" ALUMINUM CAP, DOWN 2", STAMPED "ODOT" BEARS S53°02'20"W, 19.35 FEET.
- 4) A 5/8" X 30" SMOOTH IRON ROD WITH A 1-1/2" ALUMINUM CAP, DOWN 2", STAMPED "ODOT" BEARS N48°26'46"W, 23.13 FEET.

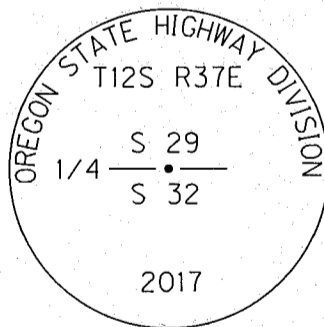

WITNESSES:  
 MARK STEWART, CHASE KING

I HEREBY CERTIFY THAT THE ABOVE CORNER POSITION WAS RE-ESTABLISHED AS HEREON DESCRIBED ON MARCH 27, 2017.

REGISTERED  
 PROFESSIONAL  
 LAND SURVEYOR

*Bret N. Elithorp*

OREGON  
 JAN 14, 2003  
 BRET N. ELITHORP  
 61348

RENEWS: 12/31/2017

OREGON DEPARTMENT OF TRANSPORTATION



FILED May 17, 2017

BAKER COUNTY SURVEYOR

SURVEY NO. 12-37-107

Section	UNITY RESEVOIR QUARRY		
Highway	DOOLEY MOUNTAIN HIGHWAY		
County	BAKER	Scale	NTS
Purpose	QUARRY BOUNDARY	Date	APRIL 11, 2017