



MATCH SHEET 2 SHEET 3

DOOLEY
T12S R39E

MAGNETIC DECLINATION 20° EAST

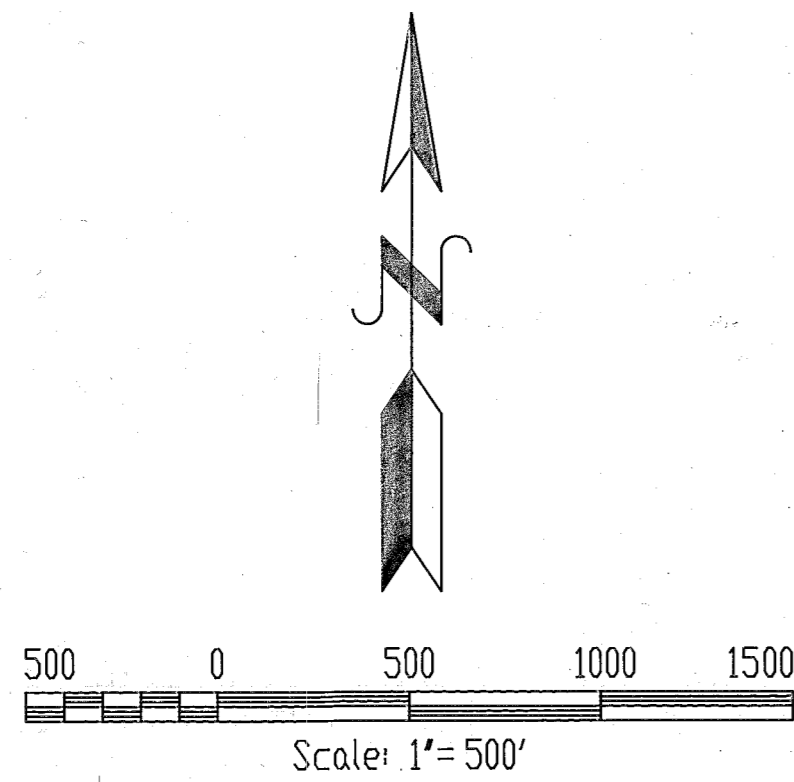

BASIS OF BEARING: SOLAR OBSERVATIONS

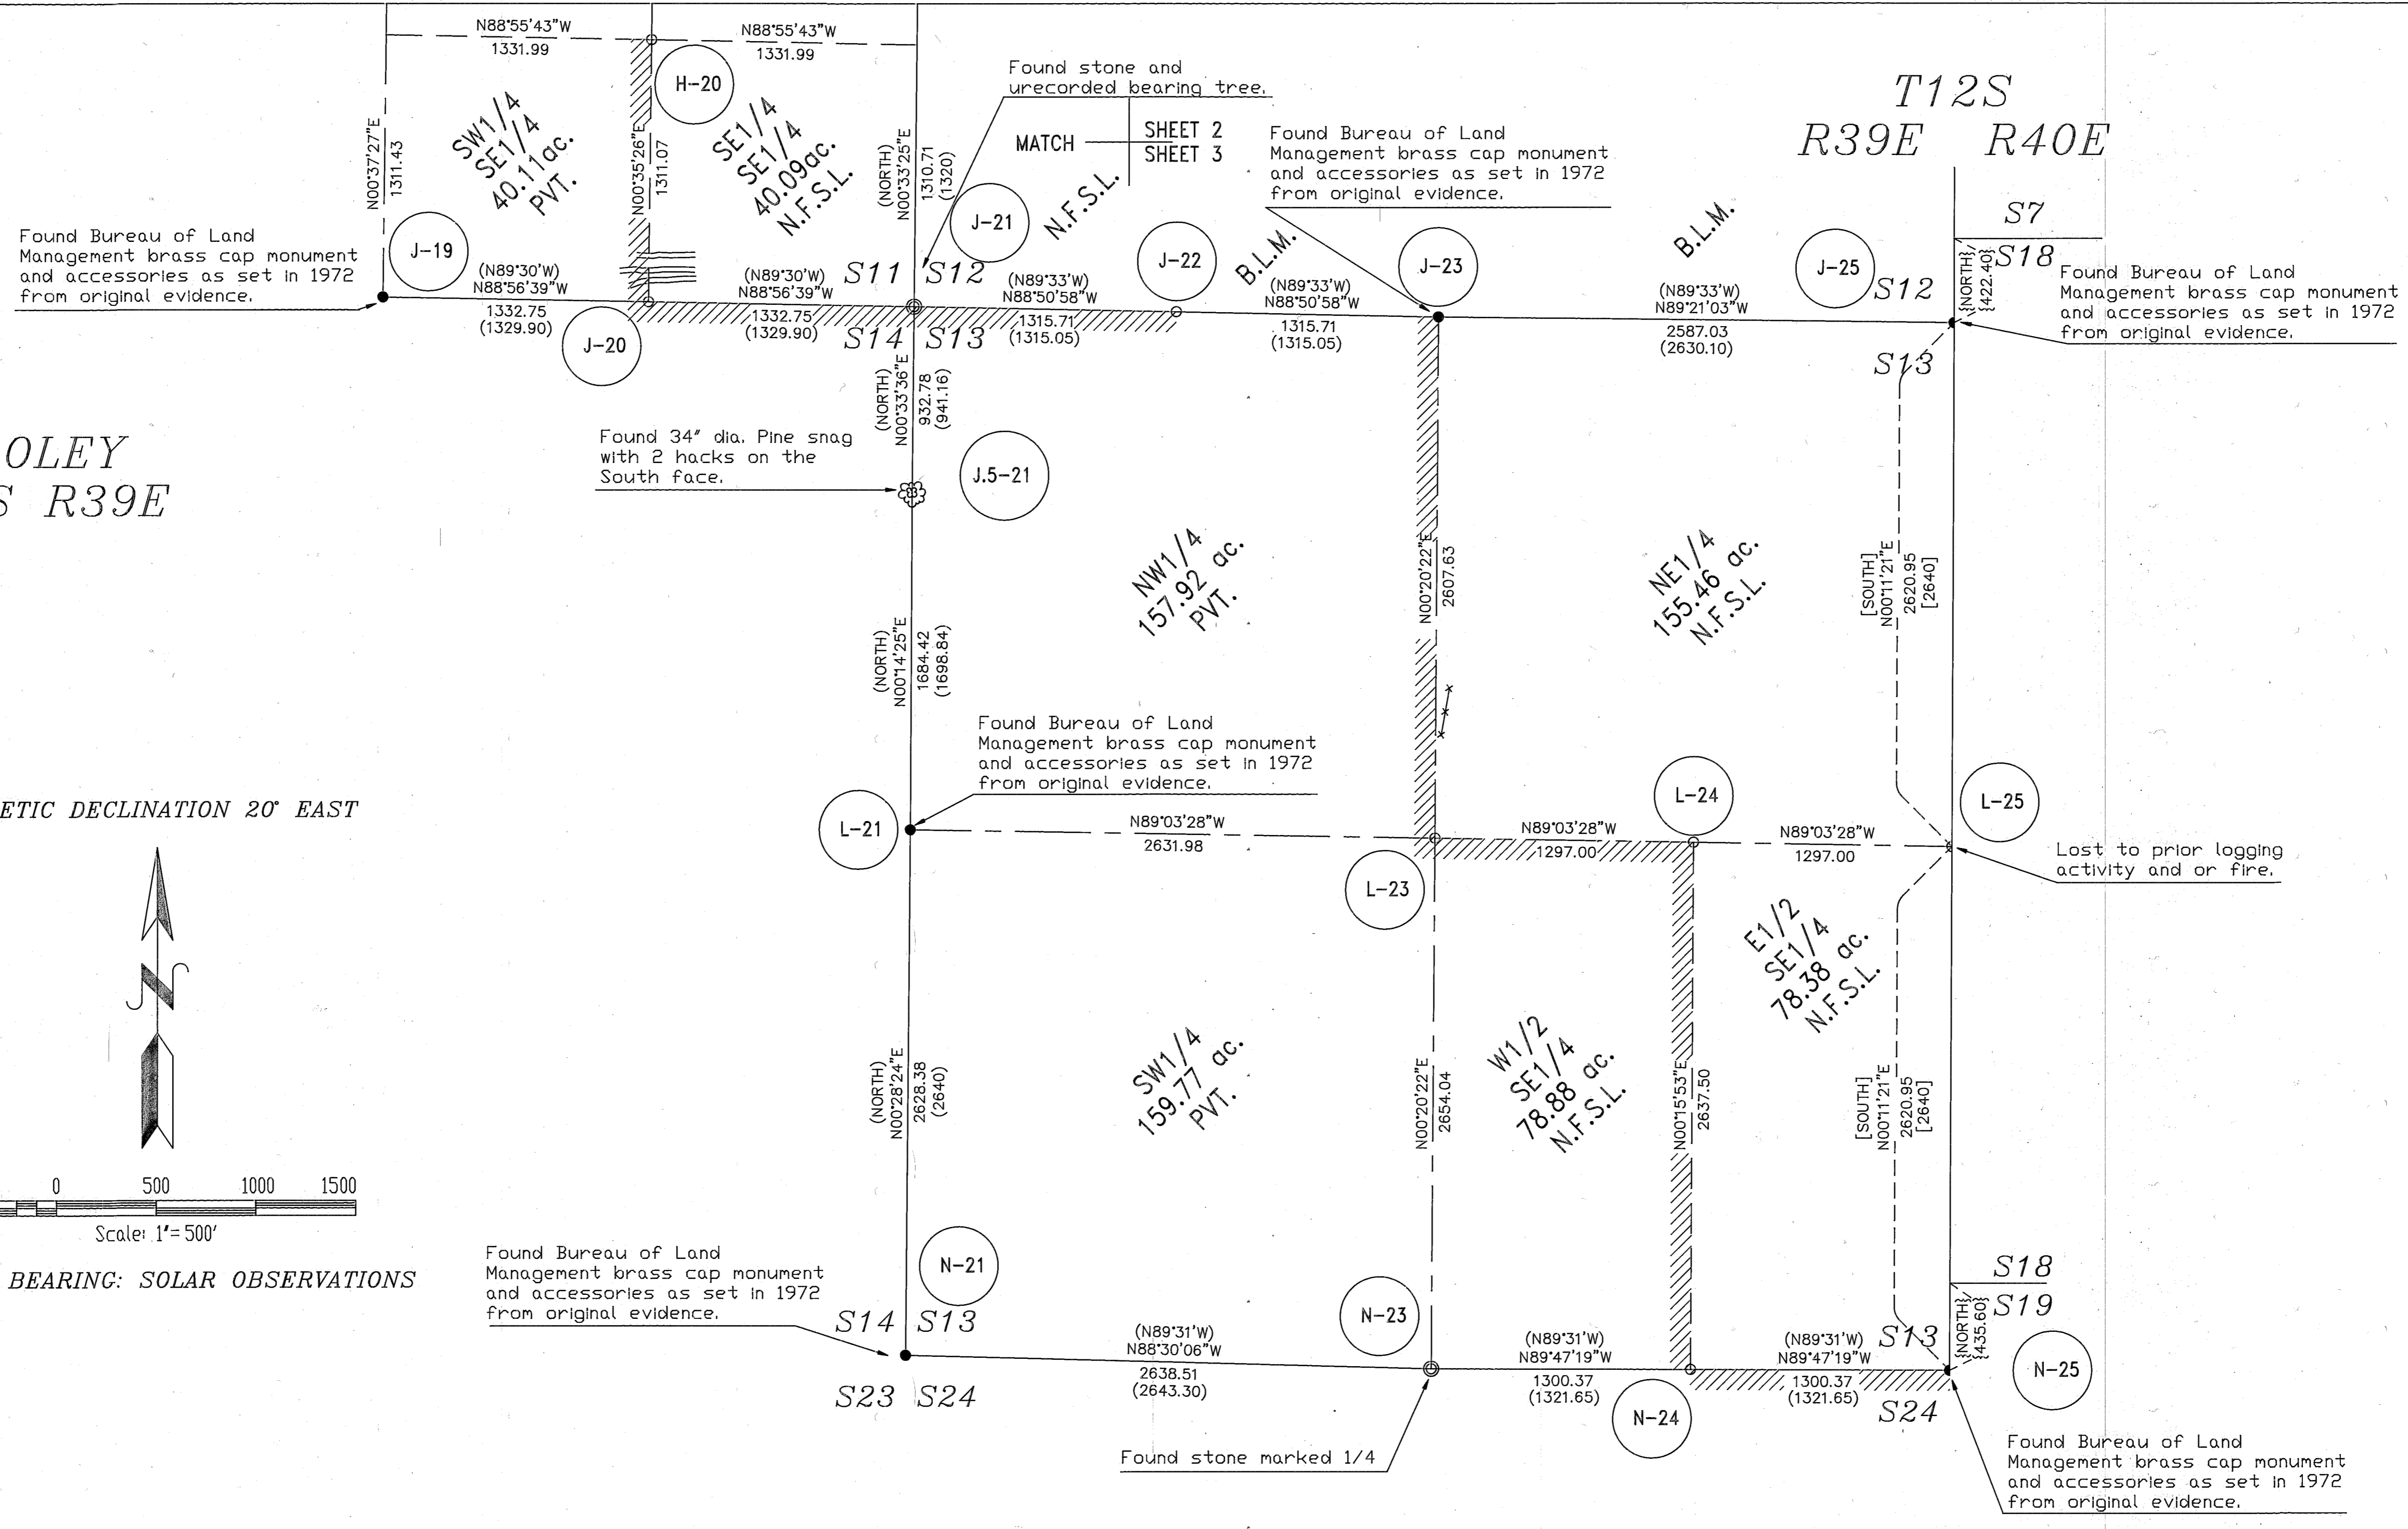

REGISTERED PROFESSIONAL LAND SURVEYOR
OREGON
JULY 12, 1968
DOUGLAS M. FERGUSON
848