


CERTIFIED RECORD OF LAND CORNER MONUMENTATION

HISTORY OF ORIGINAL CORNER ESTABLISHED:

Corner not previously established

T 12 S R 40 E Y-13

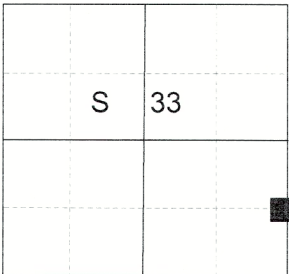

DESCRIPTION OF CORNER EVIDENCE FOUND:


None.

DESCRIPTION OF MONUMENT AND ACCESSORIES I ESTABLISHED TO MONUMENT THE ORIGINAL LOCATION OF THIS CORNER:

At position by Survey I set a 5/8" X 30" iron pin, 27" in the ground, with 2 1/2" aluminum cap marked as shown below, from which:

NEW BEARING OBJECTS:

A 5/8" X 15" iron pin bears South 22°18' West, a distance of 17.19 feet, with 1 1/2" aluminum cap marked "BGB SURVEY MARKER SRP".
A 5/8" X 15" iron pin bears North 52°09' West, a distance of 9.68 feet, with 1 1/2" aluminum cap marked "BGB SURVEY MARKER NRP".

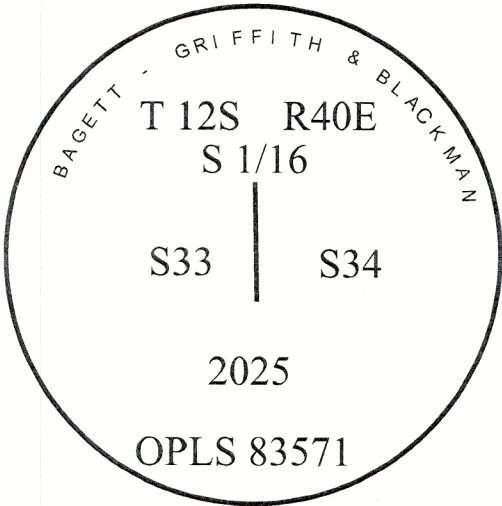

I hereby certify that the corner was monumented on May 8, 2025

Witness: Kyle Tucker



Renewal Date: June 30, 2027

I use a Leica GS18 with RTK in the establishment of the new bearing objects. Basis of Bearing is as per the "Oregon Coordinate Reference System Baker Zone". Bearings and distances are measured to the center of the aluminum caps.

Y-13

FILED June 25, 2025
BAKER COUNTY SURVEYOR
SURVEY NO. 12-40-37