

CERTIFIED RECORD OF LAND CORNER MONUMENTATION

HISTORY OF ORIGINAL CORNER ESTABLISHED:

Corner was originally established under GLO contract number 148, dated May 17th, 1871, executed by John S. Kincaid. Surveyor General field notes state:

Set stone 15x12x10 for Cor. Secs. 4, 5, 32, + 33

T 13 S R 40 E A-09

	S	4	

DESCRIPTION OF CORNER EVIDENCE FOUND:

None. Multiple stones of called size fall in the area which has been recently logged, none of which I can find discernible marks.

DESCRIPTION OF MONUMENT AND ACCESSORIES I ESTABLISHED TO MONUMENT THE ORIGINAL LOCATION OF THIS CORNER:

At proportionate position, I set a 2 1/2" aluminum pipe, 27" in the ground, with 3" aluminum cap marked as shown below, and in a 2 ft. diam. collar of stone, from which:


NEW BEARING OBJECTS:

A 7" Juniper bears North 34° East, a distance of 31.20 feet, marked T12SR40E S33 BT.
A 14" Ponderosa Pine bears South 73° East, a distance of 25.55 feet, marked T13SR40E S4 BT.
A 13" Ponderosa Pine bears South 23° West, a distance of 7.85 feet, marked T13SR40E S5 BT.
A 12" Juniper bears North 61° West, a distance of 26.80 feet, marked T12SR40E S32 BT.

Set steel fence post approx. 1 ft. East

I hereby certify that the corner was monumented on May 1, 2025

Witness: Kyle Tucker

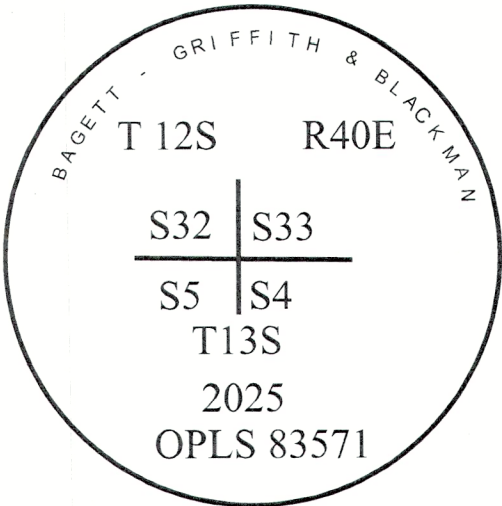

Renewal Date: June 30, 2027

I use a steel tape and compass in the establishment of the new accessories. Magnetic declination used was 14° East. Bearings are to a brass washer in the BT blaze marked OPLS 83571. Distances are to a 60d spike driven in the root crown of the right side of the trees.

A-09

FILED June 25, 2025
BAKER COUNTY SURVEYOR
SURVEY NO. 12-40-39
13-40-3