

CERTIFIED RECORD OF LAND CORNER MONUMENTATION

HISTORY OF ORIGINAL CORNER ESTABLISHED:

Corner was originally established under GLO contract number 148, dated May 17th, 1871, executed by John S. Kincaid. Surveyor General field notes state:

Set stone 15x14x7 for Cor. Secs. 3, 4, 33, + 34

T 13 S R 40 E A-13

	S	4	

DESCRIPTION OF CORNER EVIDENCE FOUND:

Found 17" x 5" x 8" stone with 3 notches in ancient fence cor.

DESCRIPTION OF MONUMENT AND ACCESSORIES I ESTABLISHED TO MONUMENT THE ORIGINAL LOCATION OF THIS CORNER:

At position of found stone I set a 2 1/2" x 30" aluminum pipe, 27" in the ground, with 3" aluminum cap marked as shown below, and in a 2 ft. diam. collar of stone, from which:


NEW BEARING OBJECTS:

A 5/8" x 15" iron pin bears North 24°30' East, a distance of 15.43 feet, with 1 1/2" aluminum cap marked BGB SURVEY MARKER NE RP
A 5/8" x 15" iron pin bears South 44°04' East, a distance of 13.43 feet, with 1 1/2" aluminum cap marked BGB SURVEY MARKER SE RP
A 5/8" x 15" iron pin bears South 39°55' West, a distance of 18.76 feet, with 1 1/2" aluminum cap marked BGB SURVEY MARKER SW RP
A 5/8" x 15" iron pin bears North 51°06' West, a distance of 14.59 feet, with 1 1/2" aluminum cap marked BGB SURVEY MARKER NW RP

Set steel fence post approx. 1 ft. West

I hereby certify that the corner was monumented on May 8, 2025

Witness: Kyle Tucker

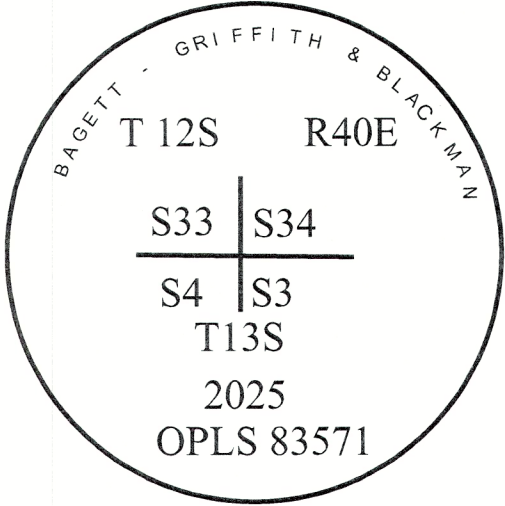

Renewal Date: June 30, 2027

I used a Leica GS18 with RTK in the establishment of the new bearing objects. Basis of Bearing is as per the "Oregon Coordinate Reference System Baker Zone". Bearings and distances are measured to the center of the aluminum caps.

A-13

FILED June 25, 2025
BAKER COUNTY SURVEYOR
SURVEY NO. 12-40-42
13-40-6