


CERTIFIED RECORD OF LAND CORNER MONUMENTATION

HISTORY OF ORIGINAL CORNER ESTABLISHED:

None

T 12 S R 41 E C-19

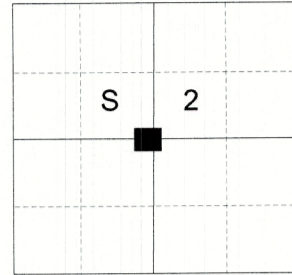

DESCRIPTION OF CORNER EVIDENCE FOUND:

NONE

DESCRIPTION OF MONUMENT AND ACCESSORIES I ESTABLISHED TO MONUMENT THE ORIGINAL LOCATION OF THIS CORNER:

At position determined by survey, I set a 2 1/2" aluminum pipe with a 3" aluminum cap, 24" in the ground marked as show below with collar of stone 2' diam., from which:

NEW BEARING OBJECTS:

- A 5/8" iron pin bears North 51°00' East, a distance of 11.38 feet, with 1 1/2" aluminum cap marked BGB SURVEY MARKER NE RP.
- A 17" Juniper South 49° East, a distance of 56.15 feet, marked C 1/4 S2 BT.
- A 5/8" iron pin bears South 61°45' West, a distance of 11.00 feet, with 1 1/2" aluminum cap marked BGB SURVEY MARKER SW RP
- A 5/8" iron pin bears North 26°30' West, a distance of 12.25 feet, with 1 1/2" aluminum cap marked BGB SURVEY MARKER NW RP

Set a steel fencepost approx. 1 ft. South


I hereby certify that the corner was monumented on May 5, 2021.

REGISTERED
PROFESSIONAL
LAND SURVEYOR



OREGON
June 2, 2010
JEFFREY S. HSU
83571

Renewal Date: June 30, 2021

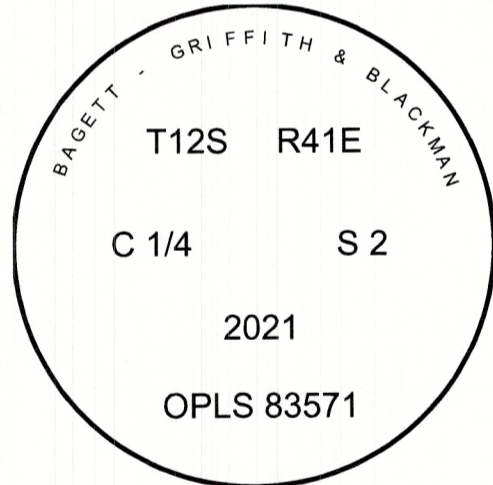

I used a Leica GS14 with RTK in the establishment of the new iron pin bearing objects. Distances and bearings are to the center of the aluminum caps. I use a magnetic compass and steel tape to establish the new bearing tree. Magnetic Declination is 14° East. Distance is measured to a 60d spike in the left side of the tree.

C-19

FILED May 12, 2021
BAKER COUNTY SURVEYOR
SURVEY NO. 12-41-40