

CERTIFIED RECORD OF LAND CORNER MONUMENTATION

HISTORY OF ORIGINAL CORNER ESTABLISHED:


Corner originally established under Contract number 409 dated August 22, 1881, executed by George Henderson. Surveyor General field notes state:

Set stone 20x4x4 ins for 1/4 sec cor marked 1/4 S on W. Side raised mound of stone around stone

Monument reset by GLO contract dated April 16, 1883 by Henry Cooke. Surveyor General field notes state:

Set basalt stone 16x12x10 ins 11 ins in ground for 1/4 sec cor marked 1/4 on west face and raised a mound of stone alongside. I then destroyed a 1/4 sec cor which bears S 80° W 161 chains distance, a stone set in a mound of stone and marked 1/4 on west face.

T 12 S R 41 E C-21

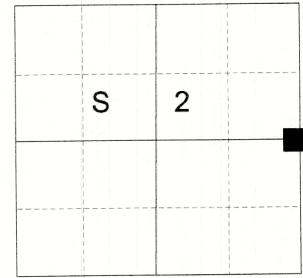

DESCRIPTION OF CORNER EVIDENCE FOUND:

NONE

DESCRIPTION OF MONUMENT AND ACCESSORIES I ESTABLISHED TO MONUMENT THE ORIGINAL LOCATION OF THIS CORNER:


At position determined by survey, I set a 2 1/2" aluminum pipe with a 3" aluminum cap, 24" in the ground marked as show below with mound of stone 1.5' diam. base to top of cap from which:

NEW BEARING OBJECTS:

- A 5/8" iron pin bears North 46°00' East, a distance of 14.32 feet, with 1 1/2" aluminum cap marked BGB SURVEY MARKER NE RP
- A 5/8" iron pin bears South 72°15' East, a distance of 16.15 feet, with 1 1/2" aluminum cap marked BGB SURVEY MARKER SE RP
- A 5/8" iron pin bears South 47°15' West, a distance of 15.35 feet, with 1 1/2" aluminum cap marked BGB SURVEY MARKER SW RP
- A 5/8" iron pin bears North 50°30' West, a distance of 16.40 feet, with 1 1/2" aluminum cap marked BGB SURVEY MARKER NW RP

Set a steel fencepost approx. 1 ft. South of coner.

I hereby certify that the corner was monumented on May 5, 2021.

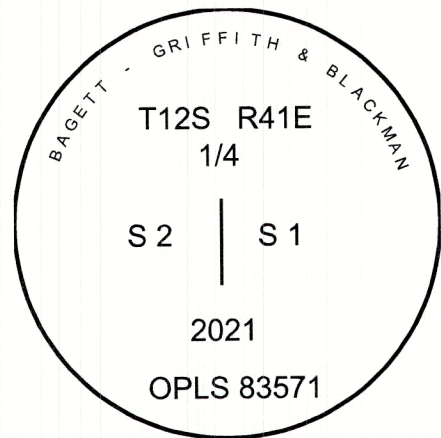

Renewal Date: June 30, 2021

I used a Leica GS14 with RTK in the establishment of the new bearing objects. Distances and bearings are to the center of the aluminum caps.

FILED May 12, 2021
BAKER COUNTY SURVEYOR
SURVEY NO. 12-41-41