

CERTIFIED RECORD OF LAND CORNER MONUMENTATION

HISTORY OF ORIGINAL CORNER ESTABLISHED:


Corner originally established by George Henderson under GLO Contract number 409 dated August 22nd, 1881. Surveyor General field notes state:

Drove pine post 3 ft long and 3 ins square for cor. to sec. 1, 2, 11, and 12 marked T12S S2 on the NW, S1 on NE S11 R41E on SW, S12 on SE faces raised mound of stone around post.

Monument recovered in GLO contract dated April 1883, executed by Henry W. Cooke. Surveyor General field notes state:

The cor to secs 1, 2, 11, 12 which is a post 4 ins square set in a stone mound and marked S1 on NE, S12 on SE, S11R41E on SW and T12S S2 on NW faces.

T 12 S R 41 E E-21

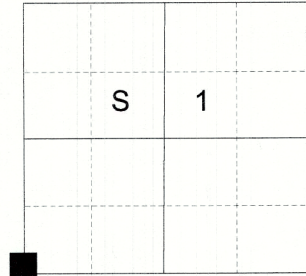

DESCRIPTION OF CORNER EVIDENCE FOUND:

NONE

DESCRIPTION OF MONUMENT AND ACCESSORIES I ESTABLISHED TO MONUMENT THE ORIGINAL LOCATION OF THIS CORNER:

At position determined by survey, I set a 30" by 2 1/2" aluminum pipe with a 3" aluminum cap, 30" in the ground marked as show below with collar of stone 2' diam., from which:

NEW BEARING OBJECTS:


A 30" Douglas Fir bears North 71° East a dist. of 16.65 ft., marked T12S R41E S1 BT.
A 26" Douglas Fir bears South 1° East a dist. of 33.90 ft., marked T12S R41E S12 BT.
A 16" Douglas Fir bears South 82° West a dist. Of 26.35 ft., marked T12S R41E S11 BT.
A 15" Triple bole Douglas Fir bears North 24° West 22.50 ft, marked T12S R41E S2 BT on center bole

Set a steel fencepost approx. 1 ft. Northwesterly.

Monument falls approx. 50 ft. Southwest of stream on steep Northeasterly aspect.

I hereby certify that the corner was monumented on May 5, 2021.

Witness: Kyle Tucker, Emmitt C. Ambert

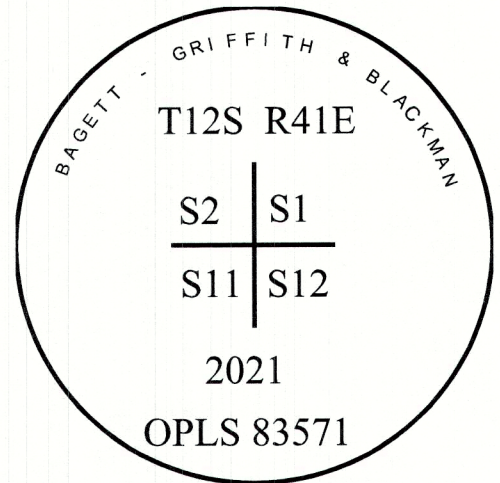

Renewal Date: June 30, 2021

I used a steel tape and magnetic compass in the establishment of the new accessories. I used 14° East declination, the distances are to a 60d spike driven into the right side of the root crown of the bearing trees. A brass washer marked OPLS 83571 is attached to the BT blaze of the new bearing trees.

FILED May 12, 2021
BAKER COUNTY SURVEYOR
SURVEY NO. 12-41-43