


CERTIFIED RECORD OF LAND CORNER MONUMENTATION

History of original corner establishment:

Subdivisions of T. 12 S., R. 43 E., W.M. were surveyed by Herman D. Gradon, Deputy Surveyor, under Contract No. 428, dated Dec. 16, 1881.

G L O record states "set a basalt stone, 22 x 8 x 4 ins., 16 ins. in the ground, for cor. to secs. 5, 6, 7 and 8, mkd. with 5 notches on S. and E. edges. Dug pits, 18 x 18 x 12 ins. in each sec., 5½ ft. dist., and raised a mound of earth in each sec., 5½ ft. dist., and raised a mound of earth, 2 ft. high, 4½ ft. base alongside."

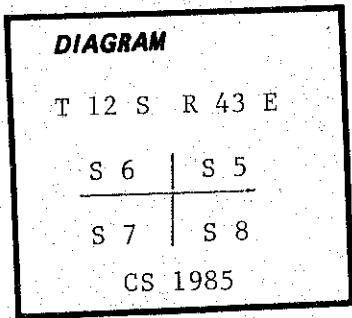


Description of corner evidence found:

An 18 x 10 x 4 ins. limestone, well set, extending 8 ins. above the ground with 5 grooves on the East side. No mounds or pits of earth discernable.

Description of monument and accessories established to perpetuate the original location of this corner:

Set a 2½-inch brass cap on a 30-inch long iron pipe, 28 inches in the ground, surrounded by a mound of stone. Deposited the marked stone under ground, 1 foot North.

Brass Cap monument is marked thus:

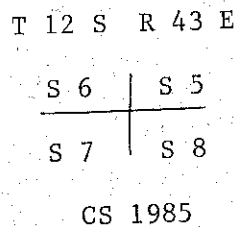

Witnessed by Tom Fisk and Chris Mahoney, July 22, 1985

**REGISTERED
PROFESSIONAL
LAND SURVEYOR**

James D. Hanley
OREGON
SEPTEMBER 23, 1977
JAMES D. HANLEY
1206

Office of...County...Surveyor..... County of...Baker.....
State of...Oregon..... I hereby certify that the within instrument was filed in this office
for record on the...25.. day of...July....., 19.85
..... by
(COUNTY OFFICIAL) (DEPUTY)

FILED July 25 1985
BAKER COUNTY SURVEYOR
SURVEY NO. 12-43-7