CERTIFIED RECORD OF LAND CORNER MONUMENTATION

RECOVERED BY	COORDINATE SYSTEM, ZONE, & UNIT	
Matthew Faulkner, Oregon PLS	United States/NAD83, Oregon North 3601, International foot	
GCDB ID	NORTHING	EASTING
100140	312,528.21	9,014,668.66
LATITUDE	LONGITUDE	
N44°28'51.395"	W117°23'09.372"	

T. 12 S., R. 44 E.

X - 1

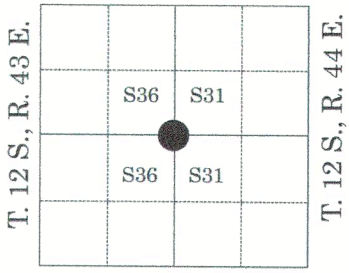

RECORD OF ORIGINAL CORNER AND SUBSEQUENT HISTORY:

Record No. 1: The 1/4 sec. cor. of secs. 31 and 36, T. 14 S., Rs. 43 and 44 E., was established and described in the original field notes of the survey of the exterior lines of Tps. 12, 13, and 14 S., Rs. 43 and 44 E., Willamette Meridian, Oregon, executed by U.S. Deputy Surveyor George Henderson in 1881, under Contract Number 402.

Description: Set a boulder in canyon for 1/4 sec. cor., marked 1/4 S on W. side, and raised mound of stone, around stone.

Record No. 2: This same corner was reestablished and described in the field notes of the resurvey of the exterior lines of T. 12 and 13 S., Rs. 43 and 44 E., Willamette Meridian, Oregon, executed by U.S. Deputy Surveyor Herman D. Gordon in 1882 under Contract Number 428 (**Note:** Mr. Gradon did not recover any of Mr. Henderson's corners on the exterior of the township).

Description: Set a basalt stone, 10x10x6 ins., 5 ins. deep, for 1/4 sec. cor., marked 1/4 on W. side, dug pits, 18x18x12 ins., 10 ins. deep, N. and S. of stone, 5 1/2 ft. dist., raised a mound of earth, 1 1/2 ft. high, 3 1/2 ft. base alongside.

Record No. 3: This same corner was again reestablished and described in the dependent resurvey of a portion of the East boundary, T. 12 S., R. 43 E., Willamette Meridian, Oregon, executed by Cadastral Surveyor Richard J. Dieckman in 2007, under Group Number 2174.

Description: Point for the 1/4 sec. cor. of secs. 31 and 36, on the E. bdy. of the Tp., at proportionate distance; there is no remaining evidence of the original cor. Set a stainless steel post, 28 ins. long, 2 1/2 ins. diam., 21 ins. in the ground, in a mound of stone, with brass cap mkd. T12S 1/4 R43E R44E S36 S31 2007. There are no suitable accessories available within limits. Deposit a magnet in a white plastic case at the base of the stainless steel post. The corner is located on a southeast slope in bunch grasses and scattered sage brush. A double track dirt road 12 ft. wide, bears N. 50° E. and S. 53° W., is south, 55 ft. dist.

DESCRIPTION OF CORNER EVIDENCE FOUND AND DESCRIPTION OF MONUMENT AND ACCESSORIES ESTABLISHED TO PERPETUATE THE LOCATION OF THIS CORNER:

Recovery Date: 8/30/2023

Description: The 1/4 sec. cor. of secs. 31 and 36, T. 12 S., Rs. 43 and 44 E., monumented with a stainless steel post, 2 1/2 ins. diam., firmly set, projecting 6 ins. above an embedded mound of stone, 2 ft. diam., with brass cap mkd. as shown below on this corner record and in the 2007 field notes.

Corner is located N., 55 ft. dist., of a double track dirt road, 12 ft. wide, bears N. 50° E. and S. 53° W.

Set a carsonite post N. of the stainless steel post, approximately 5 ft. dist.

FILED January 29, 2025
BAKER COUNTY SURVEYOR
SURVEY NO. 12-43-19
12-44-24

CERTIFIED RECORD OF LAND CORNER MONUMENTATION

Photo of the stainless steel monument in the mound of stone and with the carsonite post.

Diagram of the brass cap markings.

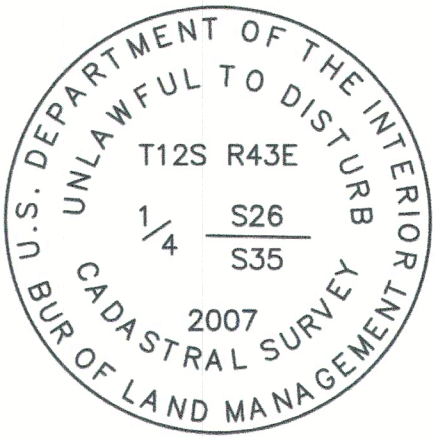

Photo No. 1 of the 2007 NW bearing tree: A juniper, 5 ins. diam., bears N. 23 °30' W., 38.8 ft. dist., mkd. X at breast height, BT at the base.

Photo No. 2 of the 2007 NW bearing tree:

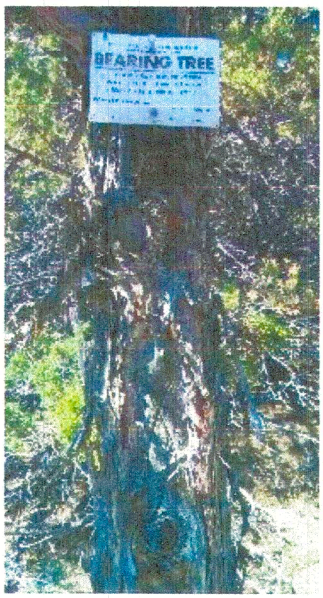

Photo of the 2007 SW bearing tree: A juniper, 12 ins. diam., bears S. 13 ° W., 32.9 ft. dist., mkd. 1/4 S35 BT.

BAKER COUNTY SURVEYOR

Date Received
January 29, 2025
Date Filed

By
12-13-19
File No. 12-44-24

REGISTERED PROFESSIONAL LAND SURVEYOR

OREGON
JUNE 08, 2009
MATTHEW J. FAULKNER
75618LS

RENEWS: 12/31/25