

GOVERNMENT CORNER RECORD

Township 12S Range 44E Section 18|17 / 19|20 County BAKER

State OREGON Date 6/21/11 Number N-5

Corner Designation : SECTION CORNER 18|17 / 19|20

- Condition Report Only
- Not Found
- Renewed
- Surveyed In
- Reference

Previous Renewals _____

Monument(s) Found: (Condition and Source)

STONE AT LOCATION SHOWN ON HIGHWAY R.O.W. PLANS

DRG. NO. 8B-30-5

MONUMENT DETAIL

Found Set

Accessories Found:

NONE




Monument & Accessories Set (Procedure and Description)

SET FENO MONUMENT, WITH 3" ALUMINUM CAP, STAMPED AS SHOWN FOR SECTION CORNER.

ORIGINAL STONE IS OF SUSPECT NATURE, SET ALONG SOUTHERLY SIDE OF MONUMENT.

Sketch of Monument, Accessories and General Area

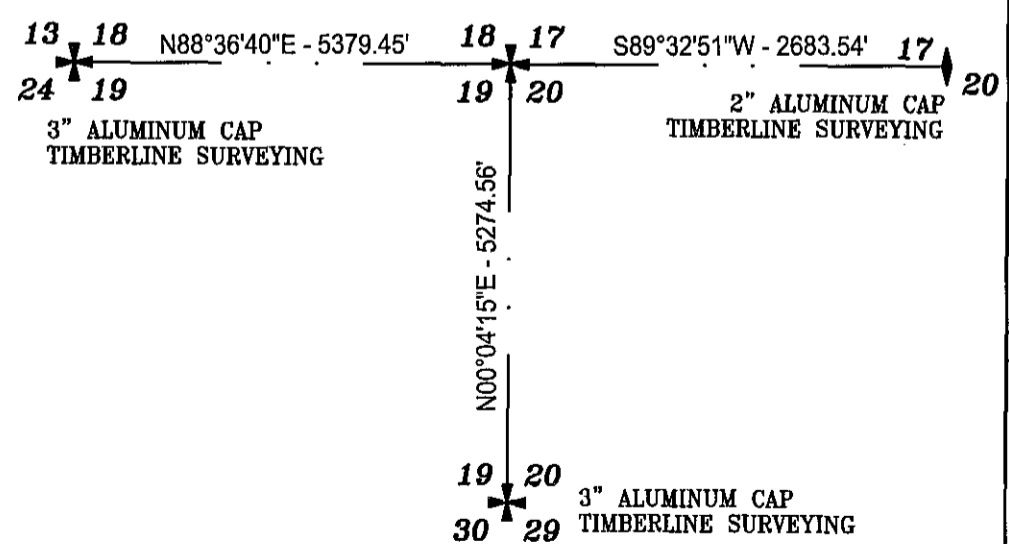

Surveyor's Seal

REGISTERED
PROFESSIONAL
LAND SURVEYOR
Russell Badgley
7/29/11
OREGON
NOVEMBER 13, 2007
RUSSELL BADGLEY
70716 LS

RENEWAL DATE : 12-31-11

Agency TIMBERLINE SURVEYING
Party Chief M. FEMENIA
Notekeeper _____
Witness(s) _____

**COUNTY SURVEYOR
RECORDING INFO**

Received _____
Filed Aug 1, 2011
Survey No. 12-44-4
Drawing No. _____
Index No. _____