

GOVERNMENT CORNER RECORD

Township 12S Range 44E Section 24|19 / 25|30 County BAKER

State OREGON Date 6/21/11 Number R-1

Corner Designation : SECTION CORNER 24|19 / 25|30

- Condition Report Only
- Not Found
- Renewed
- Surveyed In
- Reference

Previous Renewals _____

Monument(s) Found: (Condition and Source)


B.L.M. BRASS CAP IN MOUND OF STONE

Accessories Found:

NONE

MONUMENT DETAIL

Found Set

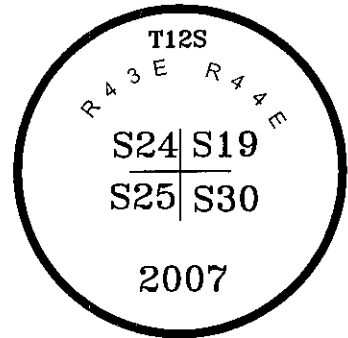


Monument & Accessories Set (Procedure and Description)

NONE

Sketch of Monument, Accessories and General Area



S01°55'41\"W - 5125.79'

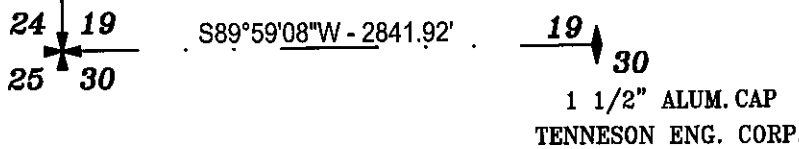

Surveyor's Seal

REGISTERED
PROFESSIONAL
LAND SURVEYOR

Russell Badgley
7/29/11

OREGON
NOVEMBER 13, 2007
RUSSELL BADGLEY
70716 LS

RENEWAL DATE : 12-31-11

Agency TIMBERLINE SURVEYING

Party Chief M. FEMENIA

Notekeeper _____

Witness(s) _____

COUNTY SURVEYOR RECORDING INFO

Received _____

Filed Aug. 1 2011

Survey No. 12-43-14
12-44-6

Drawing No. _____

Index No. _____