

GOVERNMENT CORNER RECORD

Township 12S Range 44E Section 19/20
30/29 County BAKER

State OREGON Date 8/21/11 Number R-5

Corner Designation : SECTION CORNER 19/20
30/29

- Condition Report Only
- Not Found
- Renewed
- Surveyed In
- Reference

Previous Renewals _____

Monument(s) Found: (Condition and Source)

1" IRON ROD(REMOVED)

ANCIENT FENCE REMAINING, RUNS SOUTH, WEST AND NORTH

MONUMENT DETAIL

Found Set

Accessories Found:

NONE




Monument & Accessories Set (Procedure and Description)

SET FENO MONUMENT, WITH 3" ALUMINUM CAP, STAMPED AS SHOWN FOR SECTION CORNER,

REMOVED FOUND 1" IRON ROD

Sketch of Monument, Accessories and General Area

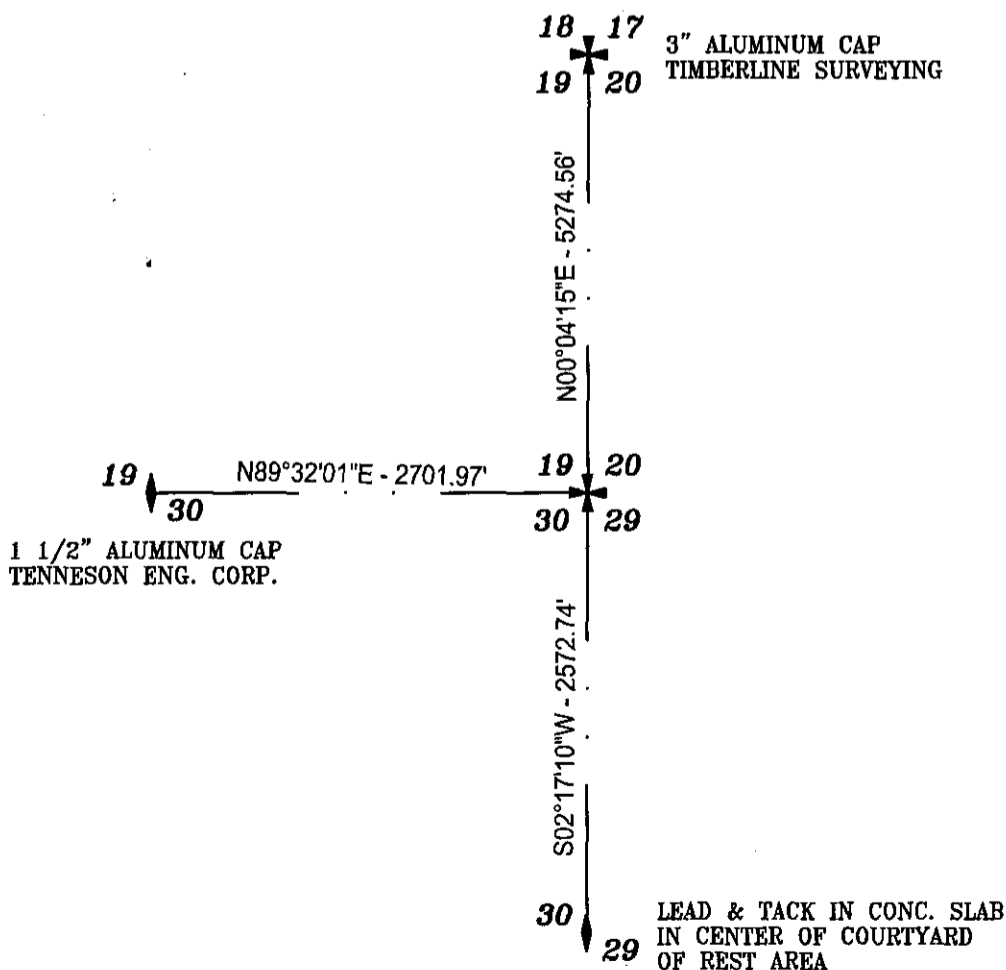

Surveyor's Seal

REGISTERED
PROFESSIONAL
LAND SURVEYOR

Russell Badgley
7/29/11

OREGON
NOVEMBER 13, 2007
RUSSELL BADGLEY
70716 LS

RENEWAL DATE : 12-31-11

Agency TIMBERLINE SURVEYING

Party Chief M. FEMENIA

Notekeeper _____

Witness(s) _____

COUNTY SURVEYOR RECORDING INFO

Received _____

Filed Aug. 1, 2011

Survey No. 12-44-8

Drawing No. _____

Index No. _____