

GOVERNMENT CORNER RECORD

Township 12S Range 44E Section 30|29 / 31|32 County BAKER

State OREGON Date 6/23/11 Number V-5

Corner Designation : SECTION CORNER 30|29 / 31|32

- Condition Report Only
- Not Found
- Renewed
- Surveyed In
- Reference

Previous Renewals _____

Monument(s) Found: (Condition and Source)


STONE AT LOCATION SHOWN ON HIGHWAY R.O.W. PLANS
 DRG. NO. 8B-30-5

Accessories Found:

NONE

MONUMENT DETAIL


Found Set

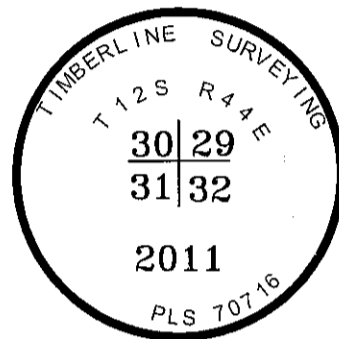

Monument & Accessories Set (Procedure and Description)

SET FENO MONUMENT, WITH 3" ALUMINUM CAP, STAMPED AS SHOWN. IN A COLLAR OF STONE 1' BASE TO TOP, WITH A MOUND OF STONES 2' BASE 1.5' HIGH. MOUND IS SOUTH OF MONUMENT.

Sketch of Monument, Accessories and General Area

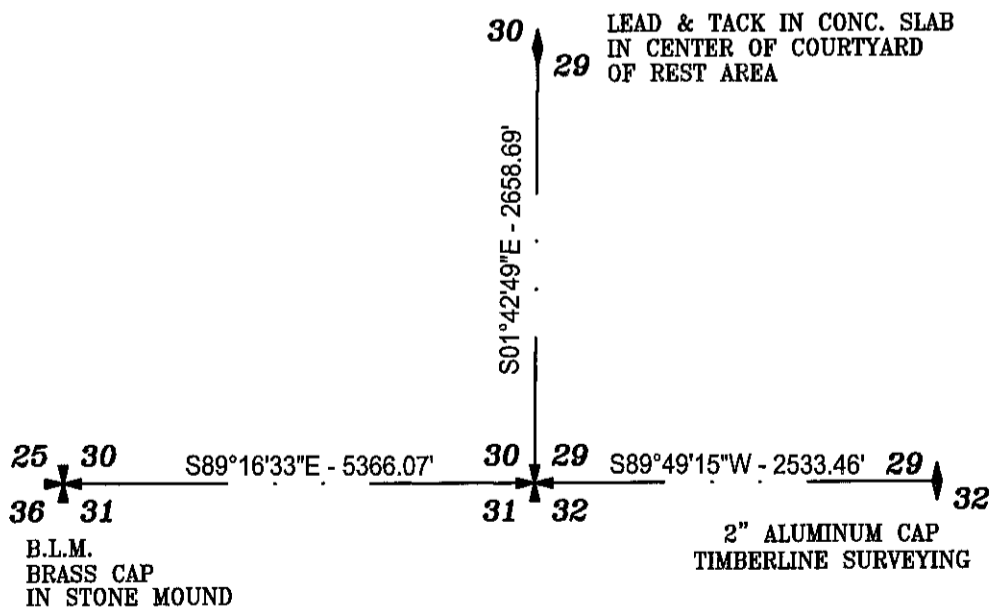

Surveyor's Seal

REGISTERED PROFESSIONAL LAND SURVEYOR

OREGON
 NOVEMBER 13, 2007
 RUSSELL BADGLEY
 70716 LS

RENEWAL DATE : 12-31-11

Agency TIMBERLINE SURVEYING

Party Chief M. FEMENIA

Notekeeper _____

Witness(s) _____

COUNTY SURVEYOR RECORDING INFO

Received _____

Filed Aug. 1, 2011

Survey No. 12-44-10

Drawing No. _____

Index No. _____