

GOVERNMENT CORNER RECORD

Township 12S Range 44E Section 29/32 County BAKER

State OREGON Date 6/21/11 Number V-7

Corner Designation : 1/4 CORNER 29/32

- Condition Report Only
- Not Found
- Renewed
- Surveyed In
- Reference

Previous Renewals _____


Monument(s) Found: (Condition and Source)

BASALT STONE 16X8X6 1/4 ON NORTH FACE

MONUMENT IN GOOD CONDITION.

MONUMENT DETAIL

Found Set

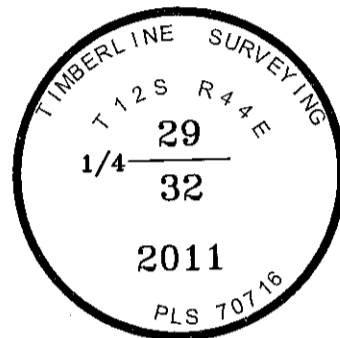


Accessories Found:

NONE

Monument & Accessories Set (Procedure and Description)

SET FENO MONUMENT, WITH 2" ALUMINUM CAP, STAMPED AS SHOWN, IN MOUND OF STONES, 1 1/2' BASE TO TOP, SET STONE ALONG NORTH SIDE.

Sketch of Monument, Accessories and General Area

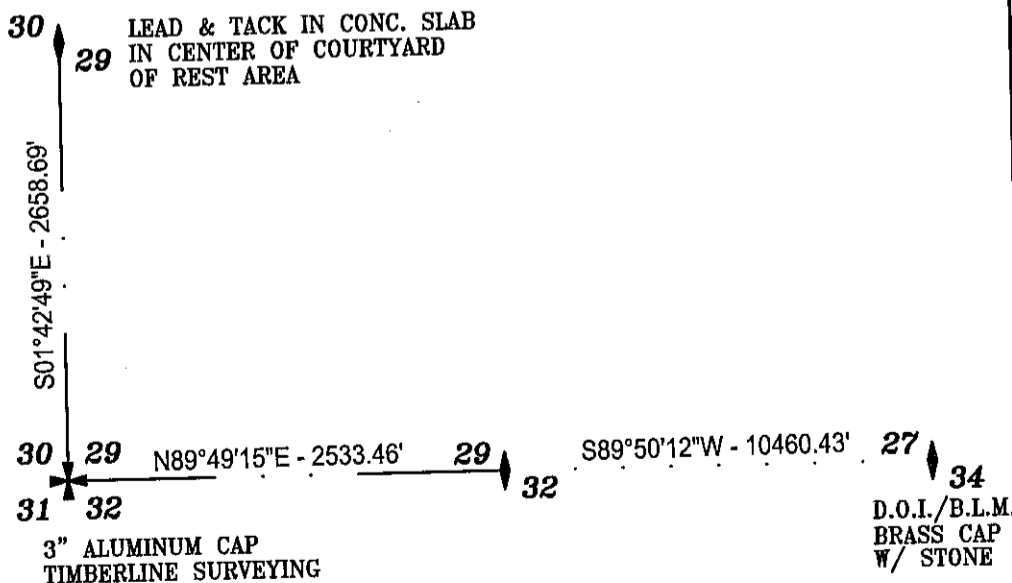

Surveyor's Seal
REGISTERED
PROFESSIONAL
LAND SURVEYOR

Russell Badgley
7/29/11

OREGON
NOVEMBER 13, 2007
RUSSELL BADGLEY
70716 LS

RENEWAL DATE : 12-31-11

Agency TIMBERLINE SURVEYING

Party Chief M. FEMENIA

Notekeeper _____

Witness(s) _____

**COUNTY SURVEYOR
RECORDING INFO**

Received _____

Filed Aug. 1, 2011

Survey No. 12-44-11

Drawing No. _____

Index No. _____