


# CERTIFIED RECORD OF LAND CORNER MONUMENTATION

(Reference FSH 5681.65)

**History of original corner establishment:**

Original subdivision was made during the early part of the year 1886. The survey was made with a mountain transit and chain, through heavy growths of Pine, Fir, and Tamarack, with undergrowths of the same.

Set a basalt stone 18 x 10 x 6, 12 ins. in the ground for cor. to sec's 9, 10, 15, and 16, marked with 4 notches on S and 3 notches on the E. edges, from which;

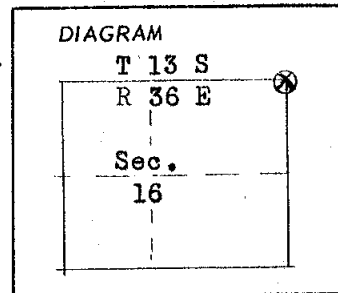

A pine 20 in. dia. bears N 75 E, 48 lks. dist. marked T 13 S, R 36 E, S 10 BT.

A pine 6 in. dia. bears N 75 W, 18 lks. dist. marked T 13 S, R 36 E, S 9 BT.

A pine 8 in. dia. bears S 70 E, 29 lks. dist. marked T 13 S, R 36 E, S 15 BT.

A pine 6 in. dia. bears S 65 W, 82 lks. dist. marked T 13 S, R 36 E, S 16 BT.

**Description of corner evidence found:**

Found mound of stone in the position of corner stone. Corner stone has been destroyed through logging operations. Mound of stone checks out to the reference distances and bearings from the bearing trees.

Found pine 20 in. dia. bears N 75 E, 48 lks. dist. marked T 13 S, R 36 E, S 10 BT.

Found pine 8 in. dia. bears S 70 E, 29 lks. dist. marked T 13 S, R 36 E, S 15 BT.


Both of the remaining bearing trees are dead and rotted away leaving no evidence.

**Description of monument and accessories I established to perpetuate the original location of this corner**

I placed more stone about the mound of stone already in place.

I placed bearing tree tags on the two bearing trees found, with the bearing and distances to the corner scribed on the tag.

I placed a corner location poster on another tree with the distance and bearing to the corner scribed on the poster.

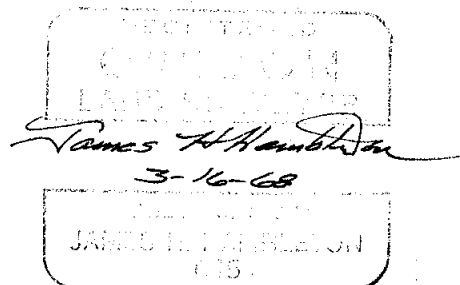

Office of County Surveyor County of Baker  
State of Oregon, I hereby certify that the within instrument was filed in this office  
for record on the 28 day of March, 1968, at 5 o'clock P.m., (signed)  
\_\_\_\_\_  
(COUNTY OFFICIAL) by Tom Hamley  
(DEPUTY)

SURVEY NO. 13-36-2