

CERTIFIED RECORD OF LAND CORNER MONUMENTATION

(Reference FSH 5681.65)


History of original corner establishment:

Original subdivision was made during the early part of the year 1886. The survey was made with a mountain transit and chain, through heavy growths of Pine, Fir, and Tamarack, with undergrowths of the same.

Set a basalt stone 12 x 12 x 8 in. 8 ins. in ground for $\frac{1}{4}$ sec. Cor., marked $\frac{1}{4}$ on the north face, from which;

A pine 22 ins. dia. bears N 55 E, 35 lks. dist. marked $\frac{1}{4}$ S BT.

A pine 20 in. dia. bears S 10 E, 52 lks. dist. marked $\frac{1}{4}$ S BT.

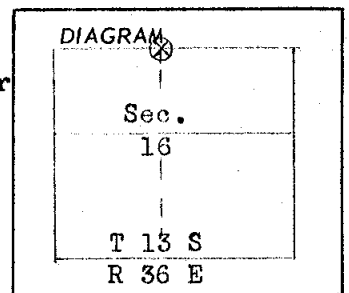

Description of corner evidence found:

Found mound of stone in the position of the $\frac{1}{4}$ cor. stone being checked by the reference distances and bearings from the bearing trees. No stone fit the dimensions, nor was marked on the N face.

Found Pine 28 in. dia. bears N 55 E, 35 lks. dist. marked $\frac{1}{4}$ S BT.


Found Pine 24 in. dia. bears S 10 E, 52 lks. dist. marked $\frac{1}{4}$ S BT.

Description of monument and accessories I established to perpetuate the original location of this corner

I placed more stone about the mound of stone already in place.

I placed bearing tree tags on the bearing trees with the bearings and distances to the $\frac{1}{4}$ sec. cor. scribed on the tags.

I placed a corner location poster on another tree with the bearing and distance to the $\frac{1}{4}$ sec. cor. scribed on the poster.

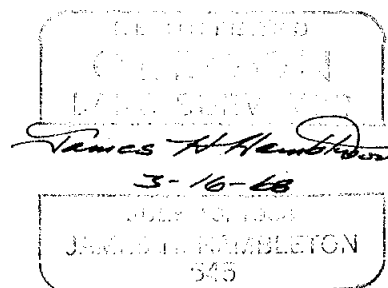

Office of County Surveyor County of Baker
 State of Oregon, I hereby certify that the within instrument was filed in this office
 for record on the 28 day of March, 1968, at 5 o'clock P.m., (signed)
Tom Hamley by Tom Hamley
 (COUNTY OFFICIAL) (DEPUTY)