


CERTIFIED RECORD OF LAND CORNER MONUMENTATION

(Reference FSH 5681.65)

History of original corner establishment:

Original subdivision was made during the early part of 1886 with a mountain transit and chain, through heavy growths of Pine, Fir, and Tamarack, with undergrowth of the same.

Set a basalt stone 18 x 16 x 14, 12 in. in the ground for cor. to sec's 8, 9, 16, and 17, marked with 4 notches on the S and E edges from which;

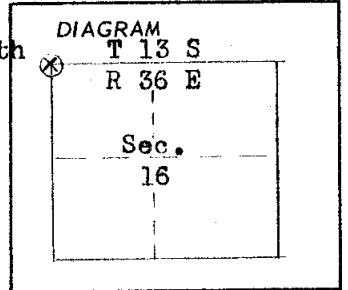

A pine 27 in. dia. bears N 45 E, 98 lks. dist. marked T 13 S, R 36 E, S 9 BT.

A juniper 30 in. dia. bears S 70 E, 97 lks. dist. marked T 13 S, R 36 E, S 16 BT.

A juniper 10 in. dia. bears S 75 W, 73 lks. dist. marked T 13 S, R 36 E, S 17 BT.

A fir 8 in. dia. bears N 20 W, 96 lks. dist. marked T 13 S, R 36 E, S 8 BT.

Description of corner evidence found:

Found a basalt stone 18 x 16 x 4 in very poor condition as it has deteriorated badly though the notches were legible, and stone lying on surface posed on a ledge of a cliff.

Found a pine stump 27 in dia. bears N 45 E, 98 lks. marked T 13 S, R 36 E, S 9 BT.

Found a juniper 30 in. dia. bears S 70 E, 97 lks. marked T 13 S, R 36 E, S 16 BT.

Found a juniper 10 in. dia. bears S 75 W, 73 lks marked T 13 S, R 36 E, S 17, BT.

The fir was dead and rotted away leaving no evidence.

Description of monument and accessories I established to perpetuate the original location of this corner

I placed a mound of stone around the sec. cor. stone in the dimensions of 2 feet dia. and 1 1/2 feet high.

I placed bearing tree tags on both of the juniper bearing trees with the bearings and distances to the sec. cor. scribed on the tags.

I also placed a corner location poster on another tree with the bearing and distance to the sec. cor. scribed on the poster.

Office of County Surveyor County of Baker
 State of Oregon, I hereby certify that the within instrument was filed in this office
 for record on the 28 day of March, 1968, at 5 o'clock P.m., (signed)
 _____ by Tom Hamley
 (COUNTY OFFICIAL) (DEPUTY)

SURVEY NO. 12-36-4