


CERTIFIED RECORD OF LAND CORNER MONUMENTATION

History of original corner establishment:

Corner established by Eugene P. McCornack under  
G.L.C. contract No. 398 dated July 2, 1881.

Surveyor's General record states:

Set a basalt stone 14"x10"x8", 10" in the ground for  
the corner to sections 13,14,23&24 marked with 3  
notches on the south and 1 notch on the east with a  
raised mound of stone along side.

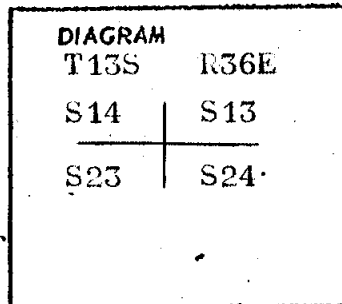

Description of corner evidence found:

Found raised mound of stone. Elbert Phipps remembers original  
corner here.


Description of monument and accessories established to perpetuate the  
original location of this corner

Set a 2" alum. Cap on a 1" iron pipe, 51" long, set in the stone  
mound.

Alum. cap marked thus:

T13S	R36E
S14	S13
S23	S24
C S 1971	

FILED Aug 14, 1971  
BAKER COUNTY SURVEYOR  
SURVEY NO. 13-36-8

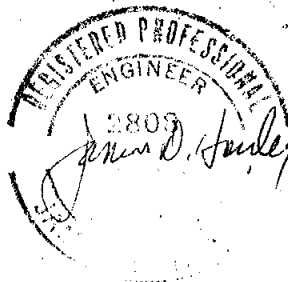

Office of Baker County Surveyor..... County of Baker.....  
State of Oregon, I hereby certify that the within instrument was filed in this office  
for record on the ..... day of .....  
..... by .....  
(COUNTY OFFICIAL) (DEPUTY)