


CERTIFIED RECORD OF LAND CORNER MONUMENTATION

History of original corner establishment:

Corner established this survey.

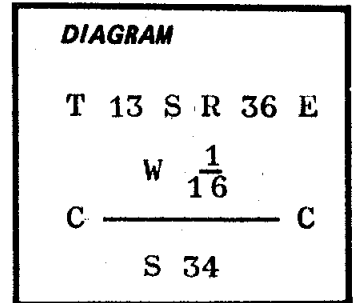

Description of corner evidence found:

None

Description of monument and accessories I established to perpetuate the original location of this corner:

Set a 2½ in. brass cap on a 2 in. iron pipe 31 ins. long and projecting 3 ins. out of the ground with a surrounding rock mound and a six foot steel fence post alongside with a sign 54-9 attached.

Brass cap marked thus: T 13 S R 36 E

W $\frac{1}{16}$

C ————— C

S 34

1979

ORLS 1639

New bearing trees:


A pine 8 ins. diam. bears S 03° W, 19.5 ft. dist. mkd CW 1/16 S 34 BT

A pine 6 ins. diam. bears N 46° W, 51.9 ft. dist. mkd CW 1/16 S 34 BT

Each new bearing tree has a sign 54-3 attached below a band of red paint and has a brass washer marked LS 1639 nailed flush with BT blaze.

I hereby certify that the above corner monument was properly established by me on Oct. 25, 1979 and witnessed by Jim DeMastus and Jeff Townsend.

Office of..... County of.....
State of....., I hereby certify that the within instrument was filed in this office
for record on the..... day of....., 19.....
..... by
(COUNTY OFFICIAL) (DEPUTY)

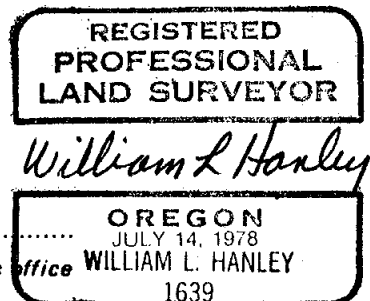

Form R6-7100-57 (9/71)

FILED OCT 26, 1979
BAKER COUNTY SURVEYOR
SURVEY NO. 13-36-10

☆ GPO—798-276