


CERTIFIED RECORD OF LAND CORNER MONUMENTATION

History of original corner establishment:

Corner established by Eugene P. McCornack under GLO contract No. 398 dated July 2, 1881.

Surveyor's General records state:

Set a basalt stone 18 x 9 x 8 ins. 12 ins. in the ground for cor to Secs. 2, 3, 34 and 35 marked with 2 notches on the E and 4 notches on the W edges and raised mound of stone alongside.

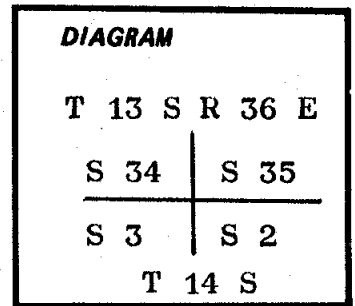


Description of corner evidence found:

A basalt stone 18 x 9 x 8 ins. firmly set and projecting 10 ins. out of the ground with 2 notches on the east edge and 3 notches on the west edge.

Description of monument and accessories I established to perpetuate the original location of this corner:

Set a 2½ in. brass cap on a 2 in. iron pipe 31 ins. long and projecting 4 ins. out of the ground with a surrounding rock mound and a six foot steel fence post alongside with a sign 54-4 and a sign 54-2 attached.

Brass cap marked thus: T 13 S R 36 E

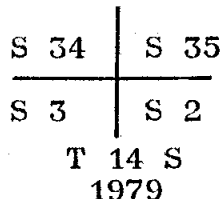

1979

ORLS 1639

New bearing trees:

A pine 10 ins. diam. bears N 22° E, 40.6 ft dist mkd T 13 S R 36 E S 35 BT
 A pine 14 ins. diam. bears S 21° E, 40.6 ft dist mkd T 14 S R 36 E S 2 BT
 A pine 20 ins. diam. bears S 79° W, 51.3 ft dist mkd T 14 S R 36 E S 3 BT
 A pine 12 ins. diam. bears N 32° W, 31.4 ft dist mkd T 13 S R 36 E S 34 BT

Each new bearing tree has a sign 54-3 attached below a band of red paint and has a brass washer marked LS 1639 nailed flush with BT blaze.

I hereby certify that the above corner monument was properly re-established by me on Oct. 29, 1979 and witnessed by Jeff Townsend.



Office of..... County of.....
 State of....., I hereby certify that the within instrument was filed in this office
 for record on the..... day of....., 19.....
 by
 (COUNTY OFFICIAL) (DEPUTY)

Form R6-7100-57 (9/71)

FILED Nov. 1, 1979
 BAKER COUNTY SURVEYOR
 SURVEY NO. 13-36-16

☆ GPO—798-276