


CERTIFIED RECORD OF LAND CORNER MONUMENTATION

History of original corner establishment:

Corner established by Eugene P. McCornack under GLO contract No. 398 dated July 2, 1881.

Surveyor's General records state:

Set a basalt stone 16 x 14 x 7 ins. 11 ins. in the ground for 1/4 Sec. Cor. marked 1/4 on the W face and raised mound of stone alongside.

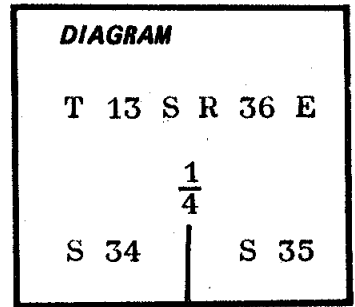

Description of corner evidence found:

A rock mound with a stone of approximately the record dimensions but no identifiable chisle work.

Description of monument and accessories | established to perpetuate the original location of this corner:

Set a 2½ in. diam. brass cap on a 2 in. iron pipe 31 ins. long and projecting 5 ins. out of the ground with a surrounding rock mound and a six foot steel fence post alongside with a sign 54-4 attached.

Brass cap marked thus: T 13 S R 36 E

	$\frac{1}{4}$	
S 34		S 35
1979		

ORLS 1639

A juniper 6 ins. diam. bears N 71° W, 82.8 ft. dist. marked 1/4 S 34 BT  
 A juniper 4 ins. diam. bears N 12° E, 69.3 ft. dist. marked 1/4 S 35 BT

Each new bearing tree has a sign 54-3 attached below a band of red paint and has a brass washer marked LS 1639 nailed flush with BT blaze.

Raised a mound of stone, the nearest point of which bears East, 5.5 ft. dist.

I hereby certify that the above corner monument was properly established by me on Oct. 30, 1979 and witnessed by Jim DeMastus and Jeff Townsend.

REGISTERED PROFESSIONAL LAND SURVEYOR
---

*William L. Hanley*

OREGON JULY 14, 1978 WILLIAM L. HANLEY 1639
--

Office of..... County of.....  
 State of....., I hereby certify that the within instrument was filed in this office  
 for record on the..... day of....., 19.....  
 ..... by .....  
 (COUNTY OFFICIAL) (DEPUTY)

Form R6-7100-57 (9/71)

FILED Nov. 1, 1979  
 BAKER COUNTY SURVEYOR  
 SURVEY NO. 13-36-17