


CERTIFIED RECORD OF LAND CORNER MONUMENTATION

History of original corner establishment:

Corner established by Eugene P. McCornack under GLO contract No. 398 dated July 2. 1881.

Surveyor's General records state:

Set a basalt stone 17 x 8 x 6 ins. 12 ins. in the ground for cor to Secs. 3, 4, 33 and 34 marked with 3 notches on the E and W edges and raised mound of stone alongside. Pits impractical.

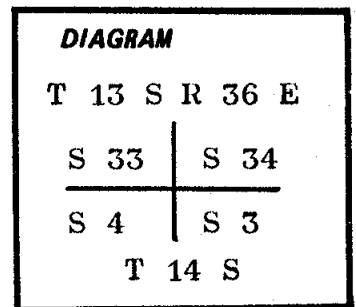


Description of corner evidence found:

A basalt stone 17 x 8 x 6 ins. firmly set marked with 3 notches on the east and west faces.

Description of monument and accessories I established to perpetuate the original location of this corner:

Set a 2½ in. brass cap on a 2 in. iron pipe 31 ins. long and projecting 5 ins. out of the ground with a surrounding rock mound and a 6 foot steel fence post alongside with a sign 54-4 and 2 signs 54-2 attached.

Brass cap marked thus: T 13 S R 36 E

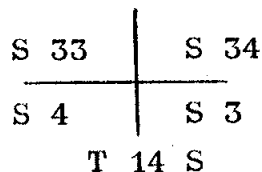

1979

ORLS 1639

There being no trees available within limits (trees destroyed by Stevens Creek forest fire) I marked the following bearing objects:

- A basalt boulder 24 x 36 ins. projecting 24 ins. out of the ground bears N 70° E, 110.4 ft. dist. marked X B0.
- A basalt boulder 36 x 48 ins. projecting 48 ins. out of the ground bears S 51° E, 84.3 ft. dist. marked X B0.
- A basalt boulder 34 x 14 ins. projecting 20 ins. out of the ground bears S 61° W, 111.5 ft. dist. marked X B0.
- A basalt stone 5 x 31 ins. projecting 30 ins. out of the ground bears N 29° W, 19.2 ft. dist. marked X B0.

I hereby certify that the above corner monument was properly re-established by me on November 6, 1979 and witnessed by Jeff Townsend. County of.....

State of....., I hereby certify that the within instrument was filed in this office for record on the..... day of....., 19.....

..... by .....  
(COUNTY OFFICIAL) (DEPUTY)

**REGISTERED  
PROFESSIONAL  
LAND SURVEYOR**

*William L. Hanley*  
**OREGON**  
JULY 14, 1978  
WILLIAM L. HANLEY  
1639

Form R6-7100-57 (9/71)

FILED Nov. 8, 1979  
BAKER COUNTY SURVEYOR  
SURVEY NO. 13-36-20