


CERTIFIED RECORD OF LAND CORNER MONUMENTATION

History of original corner establishment:

Corner established in 1886 by Henry W. Cooke under Contract No. 528.
Set 20"x12"x4" basalt stone, 15" in ground for corner to Sections 10, 11, 14 & 15, marked with 4 notches on South and 2 notched on East edge, and mound of stone.

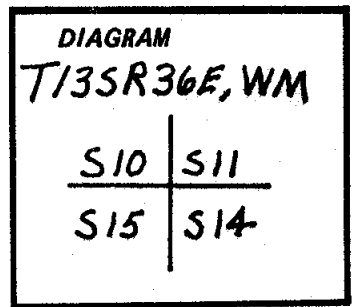

Description of corner evidence found:

Found original notched stone, with 4 notches on South face and 2 notches on East face, standing in rock mound.

Description of monument and accessories | established to perpetuate the original location of this corner:

Set 3" Brass Cap on 2½" galvanized pipe, 30" long & buried 26" in ground with stone mound around. Buried original stone on east side of cap.

New Bearing Trees:

- 8" P.Pine, N49°W, 23.0', Scribed, T13S, R36E, S10, B.T.
- 8" P.Pine, N42°E, 39.9', Scribed, T13S, R36E, S11, B.T.
- 10" P.Pine, S16°E, 32.6', Scribed, T13S, R36E, S14, B.T.
- 6" P.Pine, S25½°W, 35.2', Scribed, T13S, R36E, S15, B.T.


All B.T.'s have sign 54-4 & 54-3 attached. Set steel guard post with 54-4 sign along side B.C. Painted red band around bearing trees.
Tagged trees with L.S. 980 washer.

MONUMENT STAMPED:

Witnesses: Ross Taylor, Party Chief
David Graves, Chainman

REGISTERED
PROFESSIONAL
LAND SURVEYOR

Edgar W. Graves
OREGON
JULY 14, 1872
EDGAR W. GRAVES
980

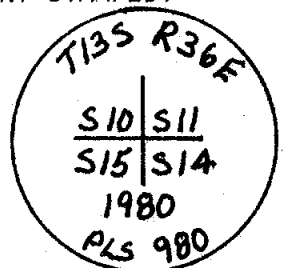

Office of..... County of.....
State of....., I hereby certify that the within instrument was filed in this office
for record on the..... day of....., 19.....
..... by
(COUNTY OFFICIAL) (DEPUTY)

Form R6-7100-57 (9/71)

FILED Aug 21, 1980
BAKER COUNTY SURVEYOR
SURVEY NO. 13-36-31

☆ GPO—798-276