


CERTIFIED RECORD OF LAND CORNER MONUMENTATION

History of original corner establishment:

Corner established in 1886 by Henry W. Cooke under Contract No. 528.
Set 14"x10"x8" basalt stone, 10" in ground for corner to Section 13, 14, 23 & 24, marked with 3 notches on the South and 1 notch on the East edges with mound of stone along side.

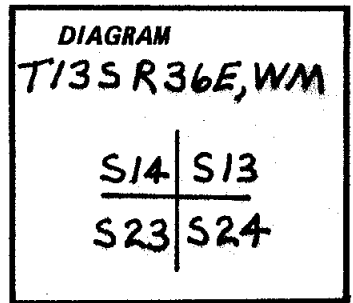

Description of corner evidence found:

Found 2½" Aluminum Cap on 1" galvanized pipe in stone mound. Corner re-established by Hanley in 1971.

Description of monument and accessories | established to perpetuate the original location of this corner:

Placed more stones around existing monument.

New Bearing Trees:

6" Juniper, N27°E, 276.5', Scribed, T13S, R36E, S13, B.T.
Dug pits 18"x18"x12" deep, 3' from corner in the NW, SE & SW quadrants.

B.T. has sign 54-4 & 54-3 attached. Set steel guard post with 54-4 sign on East side of B.C. Painted red band around bearing tree.
Tagged tree with L.S. 980 washer.


Witnesses: Ross Taylor, Party Chief
David Graves, Chainman

MONUMENT STAMPED:

REGISTERED
PROFESSIONAL
LAND SURVEYOR

Edgar W. Graves

OREGON
JULY 14, 1972
EDGAR W. GRAVES
980

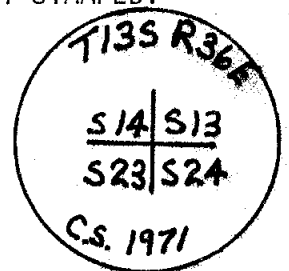

Office of..... County of.....
State of....., I hereby certify that the within instrument was filed in this office
for record on the..... day of....., 19.....
..... by
(COUNTY OFFICIAL) (DEPUTY)

Form R6-7100-57 (9/71)

☆ GPO—798-276

FILED Aug 21, 1980
BAKER COUNTY SURVEYOR
SURVEY NO. 13-36-42