


CERTIFIED RECORD OF LAND CORNER MONUMENTATION

History of original corner establishment:

Corner was not established in original survey

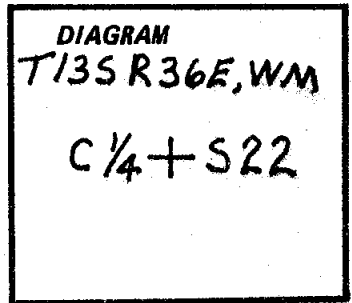

Description of corner evidence found:

None

Description of monument and accessories I established to perpetuate the original location of this corner:

Set 3" Brass Cap on 2½" galvanized pipe 30" long & buried 10" in ground and surrounded by a mound of stone.


New bearing trees:

14" P.Pine, N10°W, 61.0', Scribed C1/4 S22, B.T.
10" P.Pine, S53°W, 33.3', Scribed C1/4 S22, B.T.

All B.T.'s have sign 54-4 & 54-3 attached. Set steel guard post with 54-4 sign along side B.C. Painted red band around bearing trees. Tagged trees with L.S. 980 washer.

Witnesses: Ross Taylor, Party Chief
David Graves, Chainman

MONUMENT STAMPED:

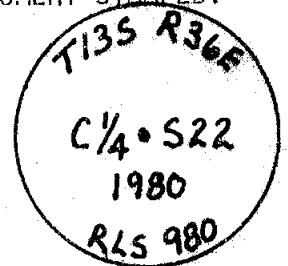

Office of..... County of.....
State of....., I hereby certify that the within instrument was filed in this office
for record on the..... day of....., 19.....
..... by
(COUNTY OFFICIAL) (DEPUTY)

Form R6-7100-57 (9/71)

FILED Aug 21, 1980
BAKER COUNTY SURVEYOR
SURVEY NO. 13-36-47

☆ GPO—798-276