


Index
File No. T 17CORNER RECORD (SEARCH)
(Ref. FSM 7151.4)Tract or
Survey No. _____Cor.
No. 1/4T 13 S R. 36 ER.D. PineCounty BakerMerid. WillametteN.F. W. W.State Oregon

CORNER DIAGRAM

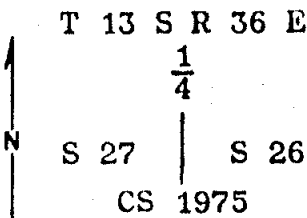

DESCRIBE CORNER MONUMENT FOUND

A 2 1/2 in. brass cap on a 1 in. iron pipe projecting 4 ins. out of the ground with a surrounding rock mound.

Brass cap marked as shown in corner diagram.

DESCRIBE BEARING TREES OR OTHER OFFICIAL ACCESSORIES FOUND

A pine stump sawed at 24 ins. and 44 ins. diam. for section 27 original record bearing tree.

New bearing trees by County Surveyor:

A pine 10 ins. diam. bears N 25° E, 63 lks dist. mkd.

1/4 S 26 BT with a brass washer marked RPE 2808.

A pine 12 ins. diam. bears S 66° W, 65 lks dist. mkd.

DESCRIBE CORNER LOCATION RELATIVE TO NEAR-BY FEATURES, ALSO HOW TO REACH CORNER 1/4 S 27 BT on a partially healed blaze with a brass washer marked RPE 2808.

PHOTO IDENTIFICATION DATA

Photo No. not ident.

Filed At. _____

Object Ident. _____

Ident. By _____

Signature _____

PLANE COORDINATE POSITION DATA

State _____ Zone _____

X _____

Y _____

Estab. By _____

Agency _____

Signature William L. Hanley Title ORLS 1639

Division _____

Headquarters _____

Date 11-16-79

7100-52 (3. 68)

CORNER RECORD (PERPETUATION)

MONUMENT: DESCRIBE NEW MONUMENT SET, OR WORK DONE TO PRESERVE EXISTING MONUMENT

Improved the surrounding rock mound and set a six foot steel fence post alongside with a sign 54-4 attached.

ACCESSORIES: DESCRIBE NEW BT'S WITNESS OBJECTS ETC. ESTABLISHED, OR WORK DONE TO PRESERVE EXISTING EVIDENCE

Applied a band of red paint above the sign 54-3 on each bearing tree and painted the blazes red.

Work Done By W. L. Hanley Title Land Surveyor Date 11-16-79 State Registration No. 1639Certified Cor. Record Prepared? XXX No _____ Filed At _____

Date _____

REMARKS

Witness: Tom Fisk

Index File No. T 17 T. 13 S R. 36 E W.M.

Tract or Surv. No. _____

Cor. 1/4REGISTERED
PROFESSIONAL
LAND SURVEYORWilliam L. HanleyOREGON
JULY 14, 1978
WILLIAM L. HANLEY
1639FILED July 9, 1982

BAKER COUNTY SURVEYOR

SURVEY NO. 13-36-54