

Index File No. V 17 CORNER RECORD (SEARCH) (Ref. PSM 7151.4) Tract or Survey No. Baker Cor. No. Sec
T 13 S R. 36 E R.D. Pine County Baker
Merid. Willamette N.F. W. W. State Oregon

CORNER DIAGRAM
T 13 S R 36 E
S 27 S 26
S 34 S 35
CS 1976

DESCRIBE CORNER MONUMENT FOUND
A 2½ in. brass cap on a 1 in. iron pipe projecting 3 ins. out of the ground with a surrounding rock mound and steel fence post alongside.
Brass cap marked as shown in corner diagram.

DESCRIBE BEARING TREES OR OTHER OFFICIAL ACCESSORIES FOUND
None

PHOTO IDENTIFICATION DATA
Photo No. EWD-12-124
Filed At. _____
Object Ident. _____
Ident. By W. L. Hanley Signature

DESCRIBE CORNER LOCATION RELATIVE TO NEAR-BY FEATURES, ALSO HOW TO REACH CORNER

PLANE COORDINATE POSITION DATA
State _____ Zone _____
X _____
Y _____
Estab. By _____ Agency

Signature William L. Hanley Title ORLS 1639 Division _____ Headquarters _____ Date 11-16-79 7100-52 (3-66)

CORNER RECORD (PERPETUATION)

MONUMENT: DESCRIBE NEW MONUMENT SET, OR WORK DONE TO PRESERVE EXISTING MONUMENT

Improved rock mound surrounding the corner monument and attached a sign 54-4 to the steel fence post.

ACCESSORIES: DESCRIBE NEW BT'S WITNESS OBJECTS ETC. ESTABLISHED, OR WORK DONE TO PRESERVE EXISTING EVIDENCE


There being no trees within limits I raised a mound of stone the nearest point of which bears West, 5.5 ft. dist.

Work Done By W. L. Hanley Title Land Surveyor Date 11-16-79 State Registration No. 1639
Certified Cor. Record Prepared? XXX No Filed At. _____ Date _____

REMARKS

Witness: Tom Fisk

Index File No. V 17 T. 13 S R. 36 E W.M. Tract or Surv. No. _____ Cor. Sec _____

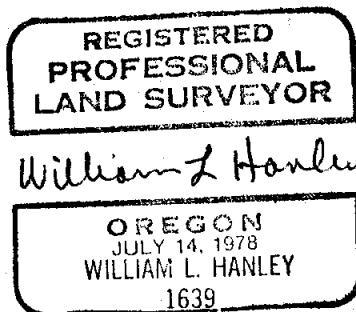

FILED July 9, 1982
BAKER COUNTY SURVEYOR
SURVEY NO. 13-36-55