


CERTIFIED RECORD OF LAND CORNER MONUMENTATION

A-13

History of original corner establishment:

Corner established by Eugene P. McCornack under contract No. 398 and dated July 02, 1881.

Surveyor General record states: Set a basalt stone 12 x 9 x 6" 8" in the ground for cor to secs 3, 4, 33 & 34 marked with 3 notches on E and W edges from which: A pine 30" diam bears N45° E, 108 lks dist marked T12SR36ES34 BT. A fir 16" diam bears S40° E, 54 lks dist marked T13SR36ES3 BT. A pine 12" diam bears S15° W, 100 lks dist marked T13SR36ES4 BT. A pine 30" diam bears N50° W, 35 lks dist marked T12SR36ES33 BT.

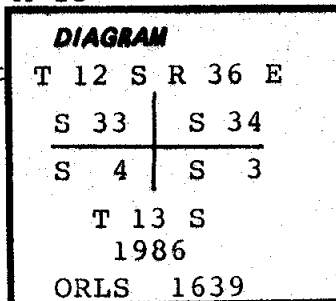

Corner re-monumented by James Hanley in 1952 and record of Baker County Survey No. 12-36-2 states: Set 2½" brass cap on a 2" iron pipe, 30" long.

Description of corner evidence found:

Did not find brass cap by James Hanley or the original stone in old skid road.

A pine stump 32" diam sawed @ 2' bears N49° E (record states N45° E), 108 lks dist marked T on rotting open blaze. A fir stump 38" diam sawed @ 3' bears S40° E, 54 lks dist marked BT inside previously opened blaze. A green ponderosa pine 27" bears S17° 30' W, 92 lks (record states S15° W, 100 lks) with healed blaze. A rotten stub 5' high bears N50° W, 35 lks with no scribes on burned face.

Description of monument and accessories | established to perpetuate the original location of this corner:

At position established by reversed record bearing and distance from original secs 33, 34, & 3 BT's...

Set 2½" aluminum pipe with 2½" aluminum cap 25" in the ground and surrounded with a mound of earth, no rocks. Cap marked as shown in corner diagram.

New bearing trees established:

A pine 6" diam bears N07° E, 25.9' marked T12SR36ES34 BT.
A pine 6" diam bears N26° W, 20.6' marked T12SR36ES33 BT.
A pine 6" diam bears S10° E, 63.2' marked T13SR36ES3 BT.

New bearing trees have a brass washer stamped PLS 1639 nailed to face of blaze. Attached sign 54-3 & 54-9 and painted face of blaze and a 6" band around each BT. Set steel fence post alongside corner and attached sign 54-9 and 54-2.

Compass declination 19° East.

I hereby certify that the above corner monument was properly re-established by me and witnessed by Jim DeMastus on November 04, 1986.

**REGISTERED
PROFESSIONAL
LAND SURVEYOR**

William L. Hanley

OREGON
JULY 14, 1978
WILLIAM L. HANLEY
1639

Office of..... County Surveyor..... County of..... Baker
State of..... Oregon....., I hereby certify that the within instrument was filed in this office
for record on the..... day of....., 19.....
..... by
(COUNTY OFFICIAL) (DEPUTY)