


CERTIFIED RECORD OF LAND CORNER MONUMENTATION

History of original corner establishment:
No previous history.

K-16

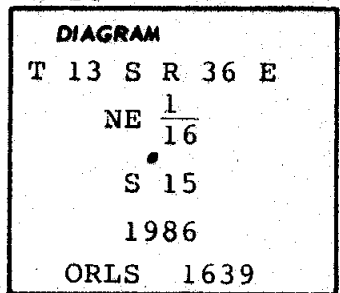

Description of corner evidence found:
None.

Description of monument and accessories established to perpetuate the original location of this corner

Corner position established by survey control from recovered corner monument set by J D Hanley marking the corners of the NE $\frac{1}{4}$ section 15, recorded under Baker County Survey No. 13-36-1 filed August 25, 1965...

Set 2 $\frac{1}{2}$ " aluminum pipe with 2 $\frac{1}{2}$ " aluminum cap 25" in the ground and surrounded with a mound of earth and stone. Cap marked as shown in corner diagram.

New bearing trees established:

A ponderosa pine 10" dia brs S46 $^{\circ}$ W, 41.2' dist marked NE1/16S15 BT.
A ponderosa pine 11" dia brs S13 $^{\circ}$ W, 44.7' dist marked NE1/16S15 BT.

New bearing trees have a brass washer stamped PLS 1639 nailed to face of blaze. Attached sign 54-3 & 54-9 and painted face of blaze and a 6" band around each BT. Set steel fence post along-side corner and attached sign 54-9.

Compass declination 19 $^{\circ}$ East.

I hereby certify that the above corner monument was properly established to U.S.F.S standards under my supervision and witnessed by Jim DeMastus on October 29, 1986.

**REGISTERED
PROFESSIONAL
LAND SURVEYOR**

William L. Hanley

OREGON
JULY 14, 1978
WILLIAM L. HANLEY
1639

Office of...County...Surveyor..... County of...Baker.....
State of...Oregon....., I hereby certify that the within instrument was filed in this office
for record on the day of; 19....., at..... o'clockm., (signed)
..... by
(COUNTY OFFICIAL) (DEPUTY)