

CERTIFIED RECORD OF LAND CORNER MONUMENTATION

Z-19


History of original corner establishment:

Corner established by Eugene P. McCornack under Contract No. 398 and dated July 02, 1881.

Surveyor General records state:

Set post 3' long 3" square 24" in ground for 1/4 Sec Cor marked 1/4S on N face from which:

A pine 14" dia brs N10°E, 11 lks dist mkd 1/4S BT.
A pine 24" dia brs S35°W, 15 lks dist mkd 1/4S BT.

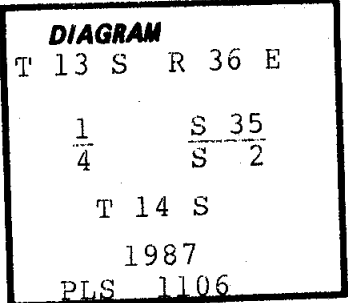

Description of corner evidence found:

A recent wood post in stone mound from which:

A 13" dead p pine brs N10°E, 7.4' with scribing visible on partially healed blaze.

A 27" live p pine (fire damaged) brs S35°W, 10.4' with scribing visible on double blaze.

Description of monument and accessories I established to perpetuate the original location of this corner:

At position of center of found mound....

Set 2½" X 30" aluminum pipe with 2½" aluminum cap 16" in the ground surrounded with a mound of earth & stone. Cap marked as shown in corner diagram.

New bearing trees established:

A 20" p pine brs N86½°E, 88.1' scribed 1/4S35 BT.

A 30" p pine brs S27½°W, 21.6' scribed 1/4S2 BT.

New BT's have a brass washer stamped PLS 1106 nailed to face of blaze. Attached signs 54-3 & 54-9 and painted face of blaze and 6" band of red around each BT. Set 6' steel fence post East of corner and attached sign 54-9 and 54-2.

Compass declination 19° East.

I hereby certify that the above corner monument was properly remonumented to U.S.F.S. standards under my supervision and witnessed by Bill Blanford on July 17, 1987.

REGISTERED
PROFESSIONAL
LAND SURVEYOR

William R. Wells

OREGON
JULY 23, 1977
WILLIAM R. WELLS
1106

Office of.....County Surveyor.....County of.....Baker.....
State of.....Oregon....., I hereby certify that the within instrument was filed in this office
for record on the.....day of....., 19.....
.....by.....
(COUNTY OFFICIAL) (DEPUTY)