

CERTIFIED RECORD OF LAND CORNER MONUMENTATION

(Reference FSH 5681.65)


History of original corner establishment:

Original subdivision was made during the early part of 1886 with a mountain transit and chain, through heavy growths of Pine, Fir, and Tamarack, with undergrowth of the same.

Set a basalt stone 12 x 12 x 10, 8 in. in ground for the $\frac{1}{4}$ sec. cor. marked $\frac{1}{4}$ on the N face from which;

A pine 34 in. dia. bears S 85 E, 26 lks. dist, marked $\frac{1}{4}$ S BT.

A pine 28 in. dia. bears S 80 W, 27 lks. dist, marked $\frac{1}{4}$ S BT.

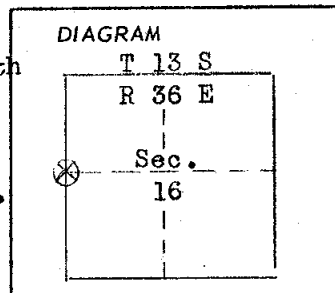

Description of corner evidence found:

Found a basalt stone 12 x 12 x 10, 6 in. in ground for $\frac{1}{4}$ cor. marked $\frac{1}{4}$ on the N face.

Found pine stump 36 in. dia. bears S 85 E, 26 lks. dist. the tree lay on the ground with the marking $\frac{1}{4}$ S BT being visible.

Found pine 28 in. dia. bears S 80 W, 27 lks. dist, the tree lay on the ground with the marking $\frac{1}{4}$ S BT still facing the corner stone.

Description of monument and accessories I established to perpetuate the original location of this corner

I placed a mound of stone around the $\frac{1}{4}$ cor. stone in the dimensions of 3 feet dia. and $1\frac{1}{2}$ feet high.

I placed two location posters on trees facing the cor. stone, with the bearing and distance to the cor. stone scribed on each of the posters.

James H. Hamilton
3-16-68
JAMES H. HAMILTON
CLK.

Office of County Surveyor County of Baker
State of Oregon, I hereby certify that the within instrument was filed in this office
for record on the 28 day of March, 1968, at 5 o'clock P.m., (signed)
by Tom Hawley
(COUNTY OFFICIAL) (DEPUTY)

CERTIFIED BY James H. Hamilton