


# CERTIFIED RECORD OF LAND CORNER MONUMENTATION

(Reference FSH 5681.65)

**History of original corner establishment:**

Original subdivision was made during the early part of the year 1886. The survey was made with a mountain transit and chain, through heavy growths of Pine, Fir, and Tamarack, with undergrowths of the same.

Set a sand stone 16 x 10 x 6, 11 ins. in ground for cor. to sec's 16, 17, 20, and 21, marked with 3 notches on S and 4 notches on E edges, from which;

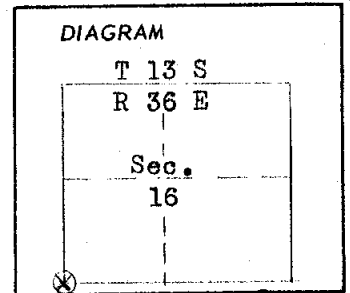

A pine 40 in. dia. bears N 40 E, 13 lks. dist. marked T 13 S, R 36 E, S 16 BT.

A pine 36 in. dia. bears S 15 E, 38 lks. dist. marked T 13 S, R 36 E, S 21 BT.

A pine 7 in. dia. bears S 45 W, 106 lks. dist. marked T 13 S, R 36 E, S 20 BT.

A fir 6 in. dia. bears N 50 W, 64 lks. dist. marked T 13 S, R 36 E, S 17 BT.

**Description of corner evidence found:**

Found a sand stone 16 x 10 x 6, 8 in. in ground for cor. to sec's 16, 17, 20, and 21 marked with 3 notches on the S and 4 notches on E faces. Notches were very hard to make out as rock has weathered some.

Found pine 40 in. dia. dead and laying on the ground.

Found pine 36 in. dia. alive and standing marked T 13 S, R 36 E, S 21 BT.


The other two bearing trees were dead and rotted away leaving no evidence.

**Description of monument and accessories established to perpetuate the original location of this corner**

I placed a mound of stone around the sec. cor. stone in the dimensions of 3 feet dia. and 1 1/2 feet high.

I placed a bearing tree tag on the living bearing tree with the distance and bearing scribed on the tag.

I also placed a corner location poster on another tree with the distance and bearing to the 1/4 cor. scribed on the poster.

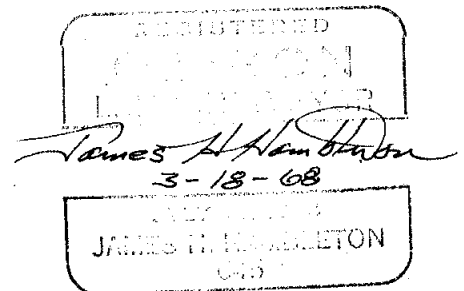

Office of County Surveyor County of Baker  
 State of Oregon, I hereby certify that the within instrument was filed in this office  
 for record on the 28 day of March, 1968, at 5 o'clock P.m., (signed)  
 \_\_\_\_\_ by Tom Hamley  
 (COUNTY OFFICIAL) (DEPUTY)

COUNTY NO. 13-33-15