

CERTIFIED RECORD OF LAND CORNER MONUMENTATION


History of original corner establishment:

Corner established by Henry W. Cooke under GLO contract No. 598 dated April 10, 1886.

Surveyor's General records state:

Set a basalt stone 12 x 9 x 7 ins. 8 ins. in the ground for 1/4 Sec. Cor. marked 1/4 on the W face, from which:

A pine 60 ins. diam. bears S 05° E., 196 lks dist. marked 1/4 S BT
A fir 6 ins. diam. bears N 10° W., 202 lks dist. marked 1/4 S BT

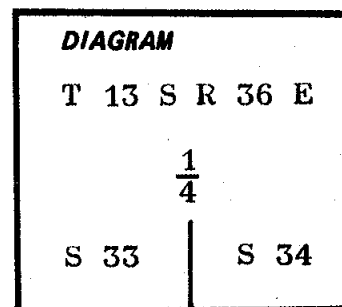

Description of corner evidence found:


A basalt stone 12 x 9 x 7 ins. lying flat on the ground with 1/4 marked on top.

A dead and downed pine 60 ins. diam. with full scribes for Section 34 record bearing tree.

Description of monument and accessories I established to perpetuate the original location of this corner:

Set a 2½ in. brass cap on a 2 in. iron pipe 31 ins. long and projecting 3 ins. out of the ground with a surrounding rock mound and a 6 foot steel fence post alongside with a sign 54-4 and a sign 54-2 attached.

Brass cap marked thus: T 13 S R 36 E

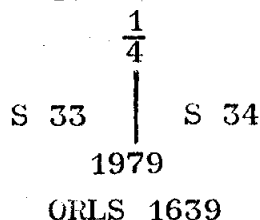

New bearing trees:

A pine 16 ins. diam. bears S 28° E, 8.5 ft. dist. marked 1/4 S 34 BT
A pine 10 ins. diam. bears S 78° W, 27.6 ft. dist. marked 1/4 S 33 BT

Each new bearing tree has a sign 54-3 attached below a band of red paint and has a brass washer marked LS 1639 nailed flush with BT blaze.

I hereby certify that the above corner monument was properly re-established by me on November 6, 1979 and witnessed by Jeff Townsend.

**REGISTERED
PROFESSIONAL
LAND SURVEYOR**

William L. Hanley

OREGON
JULY 14, 1978
WILLIAM L. HANLEY
1639

Office of..... County of.....
State of....., I hereby certify that the within instrument was filed in this office
for record on the..... day of....., 19.....
..... by
(COUNTY OFFICIAL) (DEPUTY)

Form R6-7100-57 (9/71)

FILED Nov. 8, 1979
BAKER COUNTY SURVEYOR
SURVEY NO. 13-36-19