


CERTIFIED RECORD OF LAND CORNER MONUMENTATION

History of original corner establishment:

No previous history.

B-15

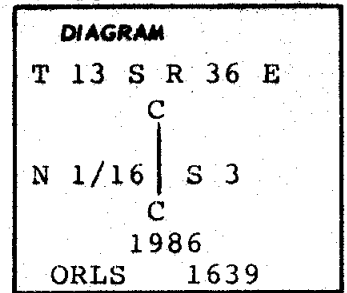

Description of corner evidence found:

None.

Description of monument and accessories established to perpetuate the original location of this corner

At position established by survey control...

Set 2 1/2" aluminum pipe with 2 1/2" aluminum cap 25" in the ground and surrounded with a mound of earth and stone. Cap marked as shown in corner diagram.


New bearing trees established:

A ponderosa pine 11" dia bears S07°E, 51.9' dist marked CN1/16S3 BT.
A ponderosa pine 6" dia bears N74°W, 70.8' dist marked CN1/16S3 BT.

New bearing trees have a brass washer stamped PLS 1639 nailed to face of blaze. Attached sign 54-3 & 54-9 and painted face of blaze and a 6" band around each BT. Set steel fence post along-side corner and attached sign 54-9 and 54-2.

Compass declination 19° East.

I hereby certify that the above corner monument was properly established to U.S.F.S standards under my supervision and witnessed by Jim DeMastus on October 30, 1986.

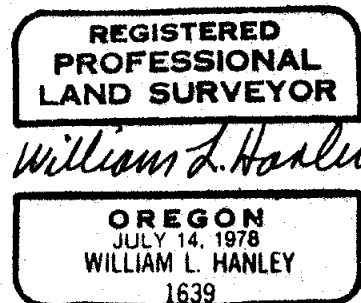

Office of County Surveyor..... County of Baker
State of Baker....., I hereby certify that the within instrument was filed in this office
for record on the day of; 19....., at..... o'clockm., (signed)
..... by
(COUNTY OFFICIAL) (DEPUTY)