


CERTIFIED RECORD OF LAND CORNER MONUMENTATION

History of original corner establishment:
No previous history.

C-15

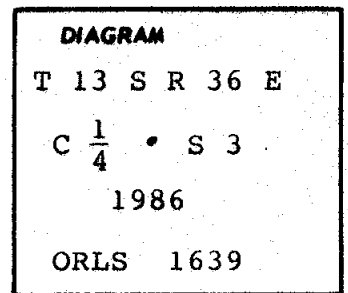

Description of corner evidence found:
None.

Description of monument and accessories I established to perpetuate the original location of this corner

At position established by survey control...

Set 2½" aluminum pipe with 2½" aluminum cap 25" in the ground and surrounded with earth mound, no rocks near. Cap marked as shown in corner diagram.

New bearing trees established:

A juniper 9" diam bears S19°E, 62.3' dist marked C1/4S3 BT.

A juniper 10" diam bears S48°E, 73.4' dist marked C1/4S3 BT.

New bearing trees have a brass washer stamped PLS 1639 nailed to face of blaze. Attached sign 54-3 & 54-9 and painted face of blaze and a 6" band around each BT. Set steel fence post along-side corner and attached sign 54-9.

Compass declination 19° East.

I hereby certify that the above corner monument was properly established to U.S.F.S standards under my supervision and witnessed by Jim DeMastus on October 30, 1986.

REGISTERED
PROFESSIONAL
LAND SURVEYOR

William L. Hanley

OREGON
JULY 14, 1978
WILLIAM L. HANLEY
1639

Office of...County Surveyor..... County of.....
State of...Oregon....., I hereby certify that the within instrument was filed in this office
for record on the day of; 19....., at..... o'clockm., (signed)
..... by
(COUNTY OFFICIAL) (DEPUTY)