

CERTIFIED RECORD OF LAND CORNER MONUMENTATION


History of original corner establishment:

Corner established by E.P.McCornack under GLO contract no.398 dated July 02, 1881.

Surveyor General records state:

Set balalt stone 14 x 12 x 7 ins 10 ins in the ground for 1/4 Sec Cor marked 1/4 on W face and raised a mound of stone alongside.

C-17

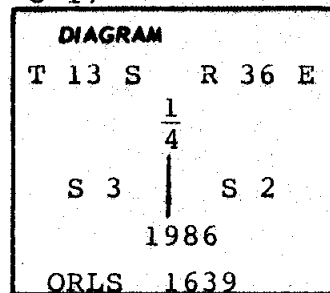

Description of corner evidence found:

No trace of original marked stone.

Searched 5 hours on 3 separate days and found no trace of corner stone or mound.

Description of monument and accessories I established to perpetuate the original location of this corner

At position established by single proportionate distance between adjacent found section corners North and South...

Set 2 1/2" aluminum pipe with 2 1/2" aluminum cap 25" in the ground and surrounded with a mound of earth and stone. Cap marked as shown in corner diagram.

New bearing trees established:

A ponderosa pine 18" dia bears S85°W, 17.8' dist marked 1/4S3 BT.  
A ponderosa pine 16" dia bears S20°E, 40.7' dist marked 1/4S2 BT.

New bearing trees have a brass washer stamped PLS 1639 nailed to face of blaze. Attached sign 54-3 & 54-9 and painted face of blaze and a 6" band around each BT. Set steel fence post alongside corner and attached sign 54-9.

Compass declination 19° East.

I hereby certify that the above corner monument was properly established to U.S.F.S standards under my supervision and witnessed by Jim DeMastus on October 31, 1986.

REGISTERED  
PROFESSIONAL  
LAND SURVEYOR

*William L. Hanley*

OREGON  
JULY 14, 1978  
WILLIAM L. HANLEY  
1639

Office of County Surveyor County of Baker  
State of Oregon, I hereby certify that the within instrument was filed in this office  
for record on the day of 19, at o'clock m., (signed)  
by  
(COUNTY OFFICIAL) (DEPUTY)