

CERTIFIED RECORD OF LAND CORNER MONUMENTATION


E-17

**History of original corner establishment:**

Corner established by Eugene P. McCornack under contract No. 398 and dated July 02, 1881.

**Surveyor General record states:**

Set basalt stone 18 x 8 x 5" 12" in the ground for cor to secs 2, 3, 10 & 11 marked with 5 notches on the S and 2 notches on the E face and raised stone mound alongside.

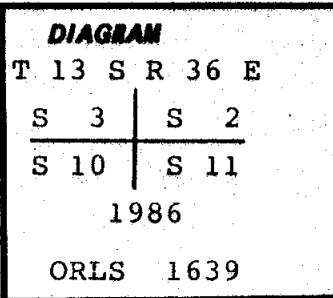

**Description of corner evidence found:**

Found basalt stone 18 x 10 x 8" marked with 5 notches on S and 2 notches on E faces with mound of stone 2' West on open East slope, no sign of previous search or disturbance.

**Description of monument and accessories I established to perpetuate the original location of this corner:**

At position of found original stone...

Set 2½" aluminum pipe with 2½" aluminum cap 22" in the ground and surrounded with a mound of earth and stones. Cap marked as shown in corner diagram. Buried original stone alongside.

**New bearing trees established:**

A pine 18" diam bears S04°W, 140.7' marked T13SR36ES10 BT.  
A pine 8" diam bears S79°E, 113.1' marked T13SR36ES11 BT.  
A juniper 12" diam bears N64°E, 57.8' marked T13SR36ES2 BT.  
A juniper 9" diam bears N57°W, 119.3' marked T13SR36ES3 BT.

New bearing trees have a brass washer stamped PLS 1639 nailed to face of blaze. Attached sign 54-3 & 54-9 and painted face of blaze and a 6" band around each BT. Set steel fence post alongside corner and attached sign 54-9.

Compass declination 19° East.

I hereby certify that the above corner monument was properly re-established by me and witnessed by Jim DeMastus on October 31, 1986.

REGISTERED  
PROFESSIONAL  
LAND SURVEYOR

*William L. Hanley*

OREGON  
JULY 14, 1978  
WILLIAM L. HANLEY  
1639

Office of.....County...Surveyor..... County of..Baker.....

State of.....Oregon....., I hereby certify that the within instrument was filed in this office

for record on the..... day of....., 19.....

..... by .....  
(COUNTY OFFICIAL) (DEPUTY)