

CERTIFIED RECORD OF LAND CORNER MONUMENTATION


G-17

History of original corner establishment:

Corner established by Eugene P. McCornack under Contract No. 398 and dated July 02, 1881.

Surveyor General record states:

Set basalt stone 18 x 12 x 4" 12" in the ground for 1/4 sec cor marked 1/4 on N face and raised a mound of stone alongside.

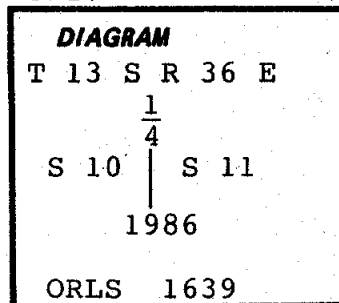

Description of corner evidence found:

Searched from survey control and found basalt stone 18 x 12 x 4" with faint 1/ on N face on steep North face of hill. Area below corner has been logged a long time ago with no disturbance at corner position.

Description of monument and accessories | established to perpetuate the original location of this corner:

At position of found stone...

Set 2½" aluminum pipe with 2½" aluminum cap 26" in the ground and surrounded with a mound of earth and stones. Cap marked as shown in corner diagram. Buried stone alongside.

New bearing trees established:

A ponderosa pine 6" diam bears N04°W, 15.5' marked 1/4S10 BT.
A ponderosa pine 6" diam bears S58°E, 41.3' marked 1/4S11 BT.

New bearing trees have a brass washer stamped PLS 1639 nailed to face of blaze. Attached sign 54-3 & 54-9 and painted face of blaze and a 6" band around each BT. Set steel fence post alongside corner and attached sign 54-9.

Compass declination 19° East.

I hereby certify that the above corner monument was properly re-established by me and witnessed by Jim DeMastus on October 31, 1986.



Office of.....County Surveyor.....County of.....Baker.....
Oregon.....
State of....., I hereby certify that the within instrument was filed in this office
for record on the..... day of....., 19.....
..... by
(COUNTY OFFICIAL) (DEPUTY)