

CERTIFIED RECORD OF LAND CORNER MONUMENTATION

Z-21


History of original corner establishment:

Corner established by Eugene P. McCornack under Contract No. 398 and dated July 02, 1881.

Surveyor General records state:

Set post 4' long 4" square 24" in ground for cor to secs 1, 2, 35 & 36 marked T12SS36 on NE, R36ES1 on SE, R14SS2 on SW, S35 on NW faces with 1 notch on E and 5 notches on W edges from which:

- A pine 40" dia brs N20°E, 184 lks dist mkd T13SR36ES36 BT.
- A pine 26" dia brs S35°E, 196 lks dist mkd T14SR36ES1 BT.
- A pine 28" dia brs S05°W, 180 lks dist mkd T14SR36ES2 BT.

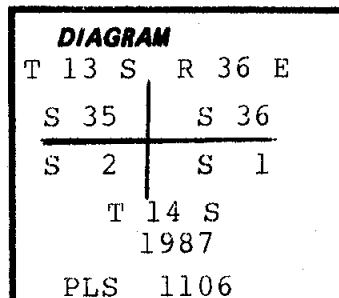

Description of corner evidence found:

A 3" brass cap on 2½" galvanized iron pipe protruding 12" from a mound of stone brs S43°22'W, 22.1' from corner position. The brass cap is not stamped.

This monument was rejected because it doesn't match record bearings & distances from found original bearing tree remains. From the monument established on this survey: A 40" p pine stump brs N20°E, 121.4' with "T" visible on lower blaze (original BT). A 30" uprooted p pine brs S35°E, 129.4' to root hole with scribing visible on lower blaze (original BT).

Note: Origin of the unstamped monument is uncertain, A 1952 map (recorded in county records), by James Hanley shows a circle at the monument position, but nothing is indicated on the map as being set.

Description of monument and accessories | established to perpetuate the original location of this corner:

At corner position re-established by measuring record bearing and distance from p pine stumps..

Set 2½" X 30" aluminum pipe with 2½" aluminum cap 24" in the ground surrounded with a mound of earth & stone. Cap marked as shown in corner diagram.

New bearing trees established:

- A 13" p pine brs N69½°E, 18.9' scribed T13SR36ES36 BT.
- A 15" p pine brs S68½°E, 13.2' scribed T14SR36ES1 BT.
- A 11" p pine brs N63½°W, 19.1' scribed T13SR36ES35 BT.
- A 18" p pine brs S52°W, 7.7' scribed T14SR36ES2 BT.

New BT's have a brass washer stamped PLS 1106 nailed to face of blaze. Attached signs 54-3 & 54-9 and painted face of blaze and 6" band of red around each BT. Set 6' steel fence post East of corner and attached sign 54-9 and 54-2.

Compass declination 19° East.

I hereby certify that the above corner monument was properly remonumented to U.S.F.S. standards under my supervision and witnessed by Bill Blanford on July 17, 1987.

REGISTERED
PROFESSIONAL
LAND SURVEYOR

William R. Wells

EXPIRATION
MAY 24, 1997
WILLIAM R. WELLS
1106

Office of.....County Surveyor..... County of...Baker.....

State of.....Oregon....., I hereby certify that the within instrument was filed in this office

for record on the..... day of....., 19.....

..... by
(COUNTY OFFICIAL) (DEPUTY)

Form R6-7100-57 (9/71)

FILED Sept 28, 1987

BAKER COUNTY SURVEYOR

13-36-79

GPO-791-311