


RECORD OF LAND CORNER MONUMENTATION

CORNER: E1/4 Cor. Sec. 35, Twp. 13 S., R. 36 E., W.M.

ORIGINAL SURVEY BY: Eugene P. McCornack, U.S. Deputy Surveyor

CONTRACT NUMBER: 398

CONTRACT DATE: July 2, 1881

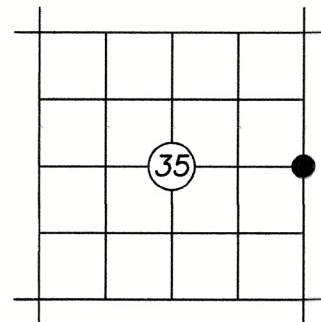

ORIGINAL G.L.O. DESCRIPTION: Set Basalt Stone 14x8x6 ins. 9 ins. in the ground for 1/4 Sec. Cor. marked 1/4 on W. face and raised a mound of stone alongside.

EVIDENCE FOUND: None, I searched for, but did not find evidence of the original GLO corner. I exhumed stones from a rock-jack in the vicinity of the search area for this corner, but found no marked stones. I determined this corner lost and calculated a position determined by single proportionate measure between the section corners to the north and south.

DESCRIPTION OF MONUMENT AND ACCESSORIES SET:

At the corner point I set a 5/8"x30" iron pin with attached 2 1/2" aluminum cap, 29" in the ground. Built a 3 ft. mound of stone around iron pin.


FROM WHICH, I SET THE FOLLOWING REFERENCE POINTS:

A 5/8"x30" iron pin bears N.62°50'E., 19.40 ft., with attached yellow plastic cap marked BENCHMARK SURVEYING

A 5/8"x30" iron pin bears S.19°27'E., 18.02 ft., with attached yellow plastic cap marked BENCHMARK SURVEYING

A 5/8"x30" iron pin bears S.52°56'W., 15.86 ft., with attached yellow plastic cap marked BENCHMARK SURVEYING

A 5/8"x30" iron pin bears N.45°08'W., 16.37 ft., with attached yellow plastic cap marked BENCHMARK SURVEYING

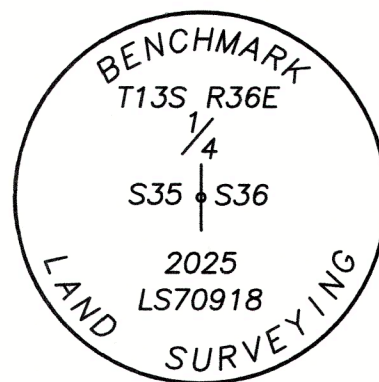


Used RTK GPS to measure Reference Points. Bearings are based on Baker County Survey No. 13-36-94.

Work Performed BY:

Michael C. Springer, PLS
Thea Ensign, Technician

Benchmark Land Surveying, Inc.
217 N. Canyon Blvd.
John Day, OR, 97845
(541) 620-0676
mike@benchmarkls.com

Surveyed: June 9, 2025

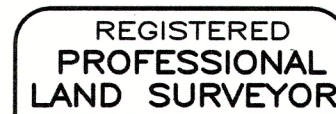

EXPIRES: 6/30/2026

FILED July 8, 2025
BAKER COUNTY SURVEYOR
SURVEY NO. 13-36-113

X-21