


RECORD OF LAND CORNER MONUMENTATION

CORNER: C-W1/16 Cor. Sec. 24, Twp. 13 S., R. 36 E., W.M.  
ORIGINAL SURVEY BY: CORNER  
CONTRACT NUMBER: NOT PREVIOUSLY  
CONTRACT DATE: ESTABLISHED

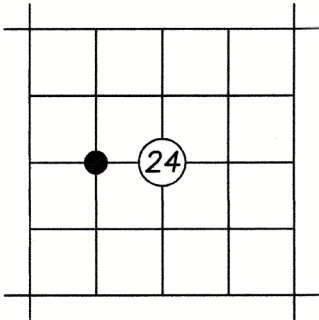


ORIGINAL G.L.O. DESCRIPTION: None, Corner not previously established.

EVIDENCE FOUND: None, Corner not previously established.

DESCRIPTION OF MONUMENT AND ACCESSORIES SET:  
At the corner point I set a 5/8"X30" iron pin with attached 2 1/2" aluminum cap, 30" in the ground.  
Cap is marked as shown below.

FROM WHICH, I SET THE FOLLOWING REFERENCE POINTS:  
A 5/8"X30" iron pin bears S.41°49'E., 24.57 ft., with attached yellow plastic cap marked BENCHMARK SURVEYING  
A 5/8"X30" iron pin bears N.48°29'W., 43.60 ft., with attached yellow plastic cap marked BENCHMARK SURVEYING

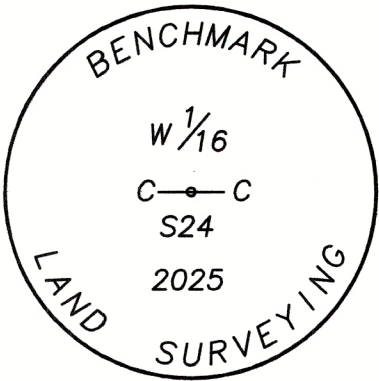

Used RTK GPS to measure Reference Points. Bearings are based on Baker County Survey No. 13-36-85.

Work Performed BY:  
Michael C. Springer, PLS  
Thea Ensign, Technician  
  
Benchmark Land Surveying, Inc.  
217 N. Canyon Blvd.  
John Day, OR, 97845  
(541) 620-0676  
mike@benchmarkls.com

Surveyed: May 5, 2025

FILED June 11, 2025  
BAKER COUNTY SURVEYOR  
SURVEY NO. 13-36-97

