


RECORD OF LAND CORNER MONUMENTATION

CORNER: E1/4 Cor. Sec. 24, Twp. 13 S., R. 36 E., W.M.
ORIGINAL SURVEY BY: Eugene P. McCornack, U.S. Deputy Surveyor
CONTRACT NUMBER: 398
CONTRACT DATE: July 2, 1881

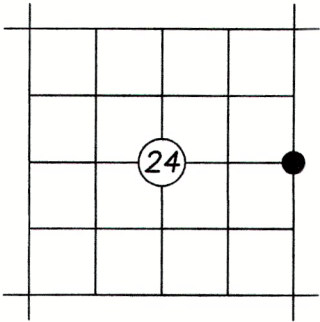


ORIGINAL G.L.O. DESCRIPTION: Set Basalt Stone 18x8x5 INS 10 ins in the ground for 1/4 Sec. cor. marked 1/4 on W face and raised a mound of stone along side. Pits impracticable.

EVIDENCE FOUND: We searched for, but could not find any remaining evidence of the original stone. The area has been used as pasture and has several fences converging in the vicinity of the corner. We found a few call size stones in and near the creek, but found no discernible marking on the stones. After a diligent search, I determine this corner lost and calculated a new position for the corner based on single proportionate measure between the Southeast corner of Section 25 and the Northeast corner of Section 24

DESCRIPTION OF MONUMENT AND ACCESSORIES SET:
At the corner point I set a 5/8"x30" iron pin with attached 3 1/2" aluminum cap, 30" in the ground. Cap is marked as shown below.

FROM WHICH, I SET THE FOLLOWING REFERENCE POINTS:
A 5/8"x30" iron pin bears N.50°24'E., 13.00 ft., with attached yellow plastic cap marked BENCHMARK SURVEYING
A 5/8"x30" iron pin bears S.37°13'E., 21.92 ft., with attached yellow plastic cap marked BENCHMARK SURVEYING, set in East-West fenceline.
A 5/8"x30" iron pin bears S.52°53'W., 18.42 ft., with attached yellow plastic cap marked BENCHMARK SURVEYING in an East-West fenceline.
A 5/8"x30" iron pin bears N.41°22'W., 34.21 ft., with attached yellow plastic cap marked BENCHMARK SURVEYING set near a south gate post.

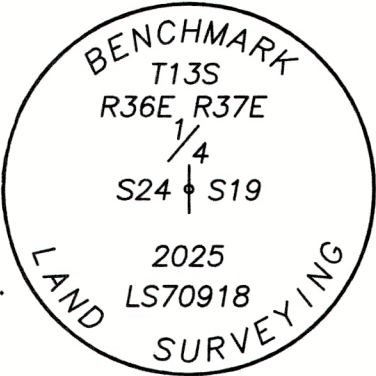

Used RTK GPS to measure Reference Points. Bearings to RP's are based on Baker County Survey 13-36-85.

Work Performed BY:
Michael C. Springer, PLS
Thea Ensign, Technician

Benchmark Land Surveying, Inc.
217 N. Canyon Blvd.
John Day, OR, 97845
(541) 620-0676
mike@benchmarkls.com

Surveyed: May 12, 2025

FILED June 11, 2025
BAKER COUNTY SURVEYOR
SURVEY NO. 13-36-98

