


RECORD OF LAND CORNER MONUMENTATION

CORNER: NW Cor. Sec. 26, Twp. 13 S., R. 36 E., W.M.

ORIGINAL SURVEY BY: Eugene P. McCornack, U.S. Deputy Surveyor

CONTRACT NUMBER: 398

CONTRACT DATE: July 2, 1881

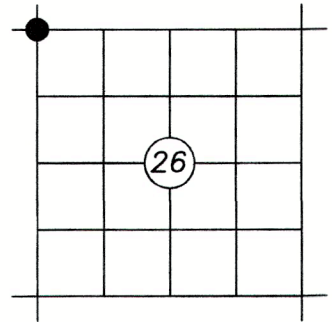

ORIGINAL G.L.O. DESCRIPTION: Set Basalt Stone 16x12x10 ins. 11 ins. in the ground for Cor to Secs 22, 23, 26 & 27 marked with 2 notches on S and 2 notches on E edges and raised a mound of stone alongside.

This fence corner position and mound of stones was shown on County Survey No's C.S. 13-36-1, 13-36-9 and 13-36-24, but no new monument was ever set.

EVIDENCE FOUND: At the intersection of fences running North, East and Southeast, we found a deconstructed rock jack with approximately 20 stones. Near the center of the mound of stones we found a stone measuring 19x9x5 set vertical in the ground. No discernible marking were found on the stone. I accept the stone and remains of the fence corner as the best available evidence of the original GLO corner.

DESCRIPTION OF MONUMENT AND ACCESSORIES SET:

At the corner point I set a 1½"X30" iron pipe with attached 3" brass cap, 22" in the ground. Buried call stone North alongside. Built a 4 ft. mound of stone around iron pipe. Cap is marked as shown below.

FROM WHICH, I SET THE FOLLOWING REFERENCE POINTS:


A 5/8"X30" iron pin bears N.61°43'E., 25.38 ft., with attached yellow plastic cap marked BENCHMARK SURVEYING

A 5/8"X30" iron pin bears S.67°47'E., 20.21 ft., with attached yellow plastic cap marked BENCHMARK SURVEYING

ALSO FROM WHICH, I SCRIBE THE FOLLOWING BEARING TREES:

A Juniper, 9" DBH, bears S.42°W., 62.4 ft., marked S27 BT

A multi-trunk Juniper, easterly trunk being 14" DBH, bears N.26°W., 30.0 ft., marked T13SR36E 1/4 S22 BT

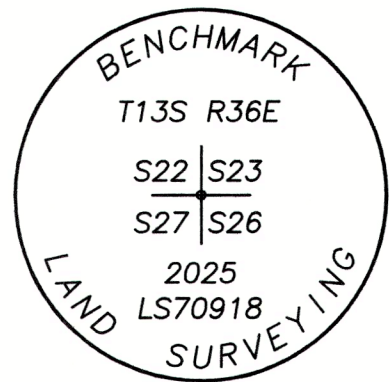

Used RTK GPS to measure Reference Points and bearing to Trees. Bearings to RP and BT are based on Baker County Survey 13-36-85. Used a steel tape to measure to a 40d nail driven into the side-center of the root crown of BT. Placed BT tag on Bearing Trees.

Work Performed BY:

Michael C. Springer, PLS
Thea Ensign, Technician

Benchmark Land Surveying, Inc.
217 N. Canyon Blvd.
John Day, OR, 97845
(541) 620-0676
mike@benchmarkls.com

Surveyed: May 2, 2025

FILED June 11, 2025
BAKER COUNTY SURVEYOR
SURVEY NO. 13-36-99



EXPIRES: 6/30/2026