


RECORD OF LAND CORNER MONUMENTATION

CORNER: N1/4 Cor. Sec. 26, Twp. 13 S., R. 36 E., W.M.

ORIGINAL SURVEY BY: Eugene P. McCornack, U.S. Deputy Surveyor

CONTRACT NUMBER: 398

CONTRACT DATE: July 2, 1881

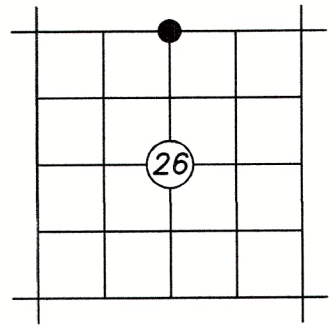

ORIGINAL G.L.O. DESCRIPTION: Set Post 3 ft. long 3 ins square with a marked stone 12" in the ground for 1/4 Sec. cor. marked 1/4 on W face. dug pits 18x18x12 ins. W+S of Cor. 5½ ft. dist. and raised a mound of earth 1½ ft. high 3½ ft. base around post.

EVIDENCE FOUND: We searched for, but could not find any remaining evidence of the wooden post, buried stone or the pits and mound. After a diligent search, I determined this corner to be lost and calculated its position by single proportionate measure between the nearest corners to the East and West. We found possible remains of old hand hewn posts in the vicinity of the proportioned location.

DESCRIPTION OF MONUMENT AND ACCESSORIES SET:

At the corner point I set a 5/8"X30" iron pin with attached 3½" aluminum cap, 26" in the ground. Cap is marked as shown below. Built a 1 ft. mound of stone around cap.

FROM WHICH, I SET THE FOLLOWING REFERENCE POINTS:

A 5/8"X30" iron pin bears N.56°50'E., 24.28 ft., with attached yellow plastic cap marked BENCHMARK SURVEYING


A 5/8"X30" iron pin bears S.39°02'W., 21.10 ft., with attached yellow plastic cap marked BENCHMARK SURVEYING

A 5/8"X30" iron pin bears N.50°14'W., 22.73 ft., with attached yellow plastic cap marked BENCHMARK SURVEYING

ALSO FROM WHICH, I SCRIBE THE FOLLOWING BEARING TREES:

A Juniper, 8" DBH, bears N.01°W., 13.8 ft., marked 1/4S23 BT.

a Juniper, 7" DB, bears S.41°E., 11.2 ft., marked 1/4S26 BT.

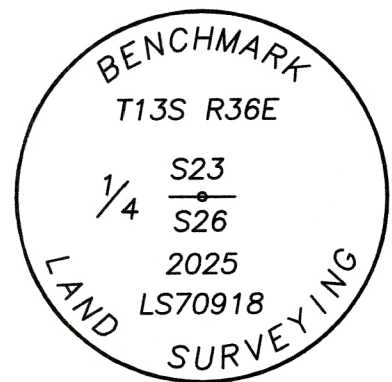

Used RTK GPS to measure Reference Points and bearing to Trees. Bearings to RP's and BT's are based on Baker County Survey 13-36-85. Used a steel tape to measure to a 40d nail driven into the side-center of the root crown of BT's. Placed BT tags on Bearing Trees.

Work Performed BY:

Michael C. Springer, PLS
Thea Ensign, Technician

Benchmark Land Surveying, Inc.
217 N. Canyon Blvd.
John Day, OR, 97845
(541) 620-0676
mike@benchmarkls.com

Surveyed: May 12, 2025

REGISTERED
PROFESSIONAL
LAND SURVEYOR

OREGON
JULY 9, 2002
MICHAEL C. SPRINGER
#70918

EXPIRES: 6/30/2026

FILED June 11, 2025
BAKER COUNTY SURVEYOR
SURVEY NO. 13-36-100