


RECORD OF LAND CORNER MONUMENTATION

CORNER: E1/16 Cor. Sec.'s 23|26, Twp. 13 S., R. 36 E., W.M.
ORIGINAL SURVEY BY: CORNER
CONTRACT NUMBER: NOT PREVIOUSLY
CONTRACT DATE: ESTABLISHED

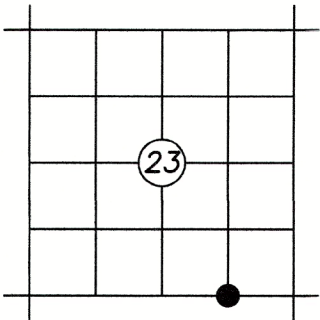


ORIGINAL G.L.O. DESCRIPTION: None, Corner not previously established.

EVIDENCE FOUND: None, Corner not previously established.

DESCRIPTION OF MONUMENT AND ACCESSORIES SET:
At the corner point I set a 5/8"X30" iron pin with attached 2 1/2" aluminum cap, 27" in the ground. Cap is marked as shown below.

FROM WHICH, I SET THE FOLLOWING REFERENCE POINTS:
A 5/8"X30" iron pin bears N.48°58'E., 26.49 ft., with attached yellow plastic cap marked BENCHMARK SURVEYING
A 5/8"X30" iron pin bears N.49°42'W., 28.79 ft., with attached yellow plastic cap marked BENCHMARK SURVEYING

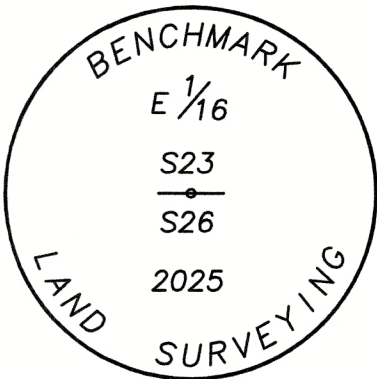

Used RTK GPS to measure Reference Points. Bearings are based on Baker County Survey No. 13-36-85.

Work Performed BY:
Michael C. Springer, PLS
Thea Ensign, Technician

Benchmark Land Surveying, Inc.
217 N. Canyon Blvd.
John Day, OR, 97845
(541) 620-0676
mike@benchmarkls.com

Surveyed: May 5, 2025



EXPIRES: 6/30/2026

FILED June 11, 2025
BAKER COUNTY SURVEYOR
SURVEY NO. 13-36-101