


RECORD OF LAND CORNER MONUMENTATION

CORNER: NE Cor. Sec. 26, Twp. 13 S., R. 36 E., W.M.

ORIGINAL SURVEY BY: Eugene P. McCornack, U.S. Deputy Surveyor

CONTRACT NUMBER: 398

CONTRACT DATE: July 2, 1881

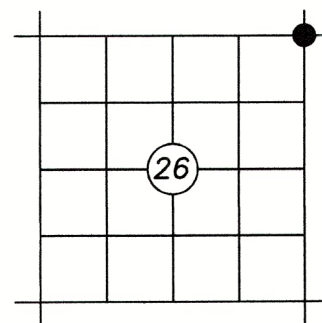

ORIGINAL G.L.O. DESCRIPTION: Set Post 4 ft. long 4 ins square 24" in the ground for cor. to Secs 23, 24, 25 and 26 marked T13S S24 on NE; R36E S25 on SE; S26 on SW and S23 on NW faces with 2 notches on S and 1 on east edges. From which
An Alder 7 ins. diam bears N40°E, 70 lks dist marked T13SR36ES24 BT.
An Alder 6 ins. diam bears S45°E, 52 lks dist marked T13SR36ES25 BT.
An Alder 7 ins. diam bears S65°W, 140 lks dist marked T13SR36ES26 BT.
An Alder 6 ins. diam bears N20°W, 113 lks dist marked T13SR36ES23 BT.

EVIDENCE FOUND: We searched for, but could not find any remaining evidence of the wooden post or any of the original bearing trees. The area has been used as a pasture for many years and is near the convergence of a creek and sloughs. After a diligent search, I determined this corner to be lost and calculated its position by double proportionate measure between the nearest corners.

DESCRIPTION OF MONUMENT AND ACCESSORIES SET:

At the corner point I set a 5/8"X30" iron pin with attached 3 1/2" aluminum cap, 30" in the ground. The Cap is marked as shown below.


FROM WHICH, I SET THE FOLLOWING REFERENCE POINTS:

A 5/8"X30" iron pin bears N.46°34'E., 17.71 ft., with attached yellow plastic cap marked BENCHMARK SURVEYING

A 5/8"X30" iron pin bears S.46°37'E., 25.39 ft., with attached yellow plastic cap marked BENCHMARK SURVEYING

A 5/8"X30" iron pin bears S.37°58'W., 13.60 ft., with attached yellow plastic cap marked BENCHMARK SURVEYING

A 5/8"X30" iron pin bears N.47°22'W., 13.99 ft., with attached yellow plastic cap marked BENCHMARK SURVEYING

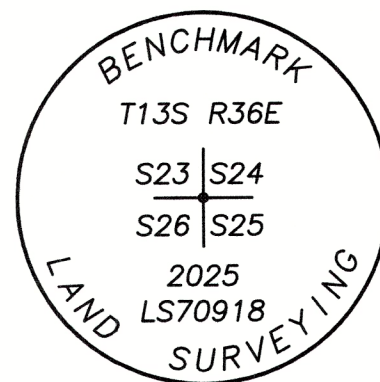

Used RTK GPS to measure Reference Points. Bearings are based on Baker County Survey 13-36-85.


Work Performed BY:

Michael C. Springer, PLS
Thea Ensign, Technician

Benchmark Land Surveying, Inc.
217 N. Canyon Blvd.
John Day, OR, 97845
(541) 620-0676
mike@benchmarkls.com

Surveyed: May 12, 2025

REGISTERED
PROFESSIONAL
LAND SURVEYOR

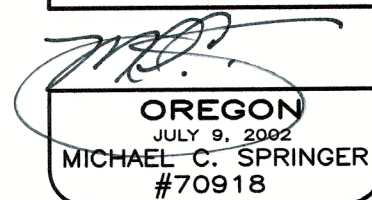

EXPIRES: 6/30/2026

FILED June 11, 2025
BAKER COUNTY SURVEYOR
SURVEY NO. 13-36-102