


RECORD OF LAND CORNER MONUMENTATION

CORNER: NE1/16 Cor. Sec. 26, Twp. 13 S., R. 36 E., W.M.

ORIGINAL SURVEY BY: CORNER

CONTRACT NUMBER: NOT PREVIOUSLY

CONTRACT DATE: ESTABLISHED

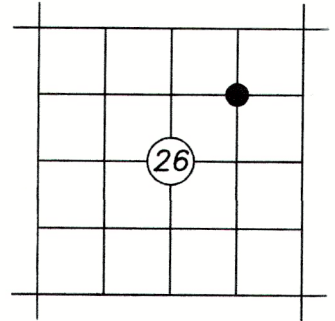

ORIGINAL G.L.O. DESCRIPTION: None, Corner not previously established.

EVIDENCE FOUND: None, Corner not previously established.


DESCRIPTION OF MONUMENT AND ACCESSORIES SET:

At the corner point I set a 5/8"X30" iron pin with attached 2 1/2" aluminum cap, 30" in the ground. Built a 2 ft. mound of stone around cap. Cap is marked as shown below.

FROM WHICH, I SET THE FOLLOWING REFERENCE POINTS:

A 5/8"X30" iron pin bears S.53°38'W., 27.47 ft., with attached yellow plastic cap marked BENCHMARK SURVEYING

A 5/8"X30" iron pin bears N.39°34'W., 28.04 ft., with attached yellow plastic cap marked BENCHMARK SURVEYING

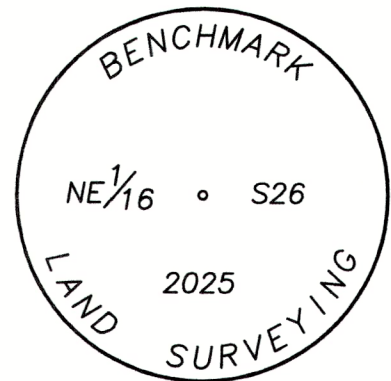

Used RTK GPS to measure Reference Points. Bearings are based on Baker County Survey No. 13-36-85.

Work Performed BY:

Michael C. Springer, PLS
Thea Ensign, Technician

Benchmark Land Surveying, Inc.
217 N. Canyon Blvd.
John Day, OR, 97845
(541) 620-0676
mike@benchmarkls.com

Surveyed: May 9, 2025

FILED June 11, 2025
BAKER COUNTY SURVEYOR
SURVEY NO. 13-36-105



EXPIRES: 6/30/2026