


RECORD OF LAND CORNER MONUMENTATION

CORNER: E1/4 Cor. Sec. 26, Twp. 13 S., R. 36 E., W.M.

ORIGINAL SURVEY BY: Eugene P. McCornack, U.S. Deputy Surveyor

CONTRACT NUMBER: 398

CONTRACT DATE: July 2, 1881

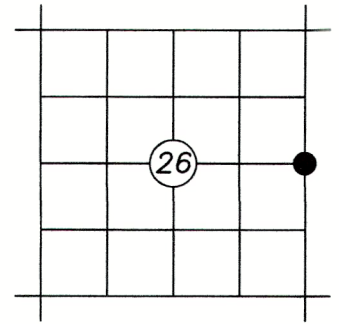

ORIGINAL G.L.O. DESCRIPTION: Set Post 3 ft. long 3 ins. square with marked stone 12 ins. in the ground for 1/4 Sec cor, marked 1/4 S on W. face. Dug Pits 18x18x12 ins W + S. of post 5 1/2 ft. dist and raised a mound of earth 1 1/2 feet high 3 1/2 ft. base around post.

EVIDENCE FOUND: None, we searched for, but did not find evidence of the original GLO post, stone or pits and mounds. The search area is covered with sage. After a diligent search, I determine this corner lost and calculated a new position by single proportionate measure between the nearest section corners to the north and south.

DESCRIPTION OF MONUMENT AND ACCESSORIES SET:

At the corner point I set a 5/8"X30" iron pin with attached 3 1/2" aluminum cap, 27" in the ground. Built a 2 ft. mound of stone around iron pin. The Cap is marked as shown below.


FROM WHICH, I SET THE FOLLOWING REFERENCE POINTS:

A 5/8"X30" iron pin bears N.46°34'E., 17.71 ft., with attached yellow plastic cap marked BENCHMARK SURVEYING

A 5/8"X30" iron pin bears S.46°37'E., 25.39 ft., with attached yellow plastic cap marked BENCHMARK SURVEYING

A 5/8"X30" iron pin bears S.37°59'W., 13.60 ft., with attached yellow plastic cap marked BENCHMARK SURVEYING

A 5/8"X30" iron pin bears N.47°22'W., 13.99 Ft., with attached yellow plastic cap marked BENCHMARK SURVEYING

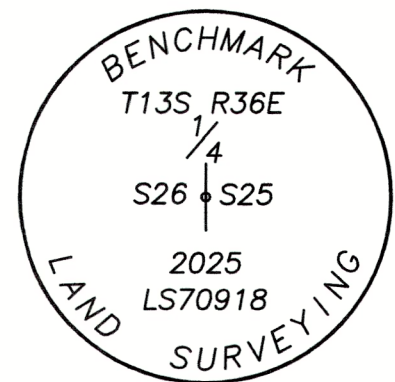


Used RTK GPS to measure Reference Points. Bearings are based on Baker County Survey 13-36-85.

Work Performed BY:

Michael C. Springer, PLS
Thea Ensign, Technician

Benchmark Land Surveying, Inc.
217 N. Canyon Blvd.
John Day, OR, 97845
(541) 620-0676
mike@benchmarkls.com

Surveyed: May 2, 2025

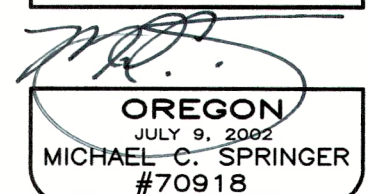

EXPIRES: 6/30/2026

FILED June 11, 2025
BAKER COUNTY SURVEYOR
SURVEY NO. 13-36-108